

CERTIFIED LAND CORNER RESTORATION

Index No. **Q-6**

State of Wisconsin

County of Oneida } ss.



I, Philip T. Hansen, do hereby certify that on the 15th day of April, 1975, I found evidence of the SW 1/4 corner of Section 20 Township 27 North, Range 27 Fourth Principal Meridian, as described hereon; and that from this evidence I established a new monument and accessories as described hereon to perpetuate the original location of this corner.

Resident witnesses:

Glen Parker

Jim O'Connell

Herb Wagner

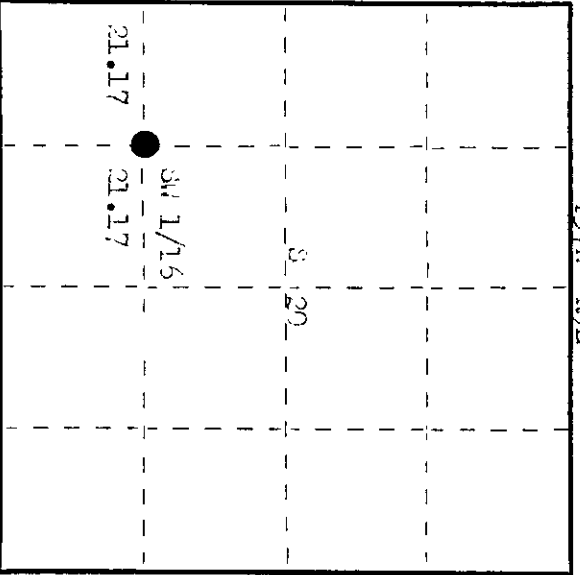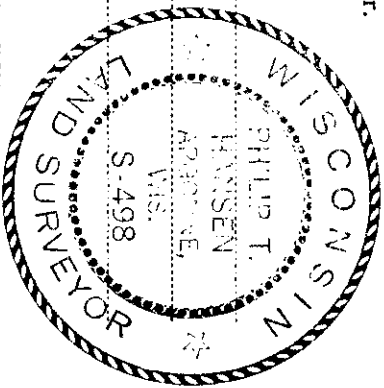

○ = Corner monument restored.

History of original corner establishment: Corner established by St. Regis Surveyors, Rollard and Drives, in 1961. Prod. provided, established on 1.15 corner pin east on bearing 271° 34' mag. and closed out 1.15 south of 1/4 on west line at 42.24 chs. Set the 30 1/4 pin driven below surface of Jim Cooper's road, south side, at 21.17 chs. Marked with - pine, 200 N 31° S 1.15 chs., oak 70 N 18° W 79.75 lks. Corneal bearing of 140° 08' Lot 4.

Description of corner evidence found: Recovered 1/2 iron pipe, buried on surface - on south edge of John E. Krebsbach's driveway. Recovered cap - 1/2 iron pipe 31° S (34° S) 1.185 chs. Corneal on 1/4 N. Oak 70 N 18° W 79.75 lks. Now a cut off stump.

Description of monument and accessories I established to perpetuate the original location of this corner.

Set a 1/2 iron pipe with 2 1/2 brass cap, 50 lks west for witness corner.  
 Wire projects 12" above ground. Cap stamped.  
 W/O - Hi line pole 3709 2019 59° S 249.5 lks.  
 Hi line pole 3709 20110 84° S 185.2 lks.  
 Measurements and bearing made to true corner.  
 SW 1/4 2/20 ...0.  
 50 lks.  
 T37N R9E  
 01-1975

Dated at Rhinelander, Wis., this 29th day of June, 1975

Signature *Philip T. Hansen* Title Registered Land Surveyor Registration No. S-498  
 (County Surveyor, Registered Land Surveyor, or other duly authorized official)

Office of Register of Deeds, County of Oneida  
 Instrument was filed in this office for record on the 23rd day of July, 1975  
 at 10 o'clock P.M. I hereby certify that the within

*Debra S. Kuehn*  
 (Register of Deeds)

By Deputy

3709201030