

CERTIFIED LAND CORNER RESTORATION



Index No. **P-6**

State of Wisconsin }
 County of Oneida } ss.

I Phillip T. Hansen, do hereby certify that on the 15th day of April, 1976, I found evidence of the MC 1/16 corner of the Section 20 Township 37, North, Range 9 East, Fourth Principal Meridian, as described hereon; and that from this evidence I established a new monument and accessories as described hereon to perpetuate the original location of this corner.

Resident witnesses:

Glenn Barker
Jim Carlson
Herb Hagoner

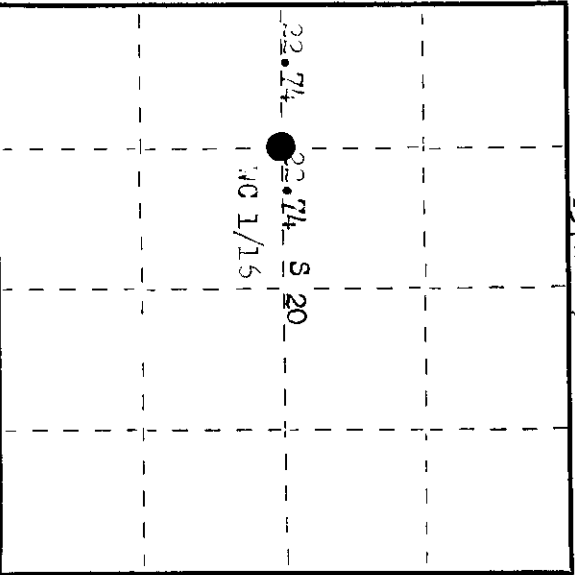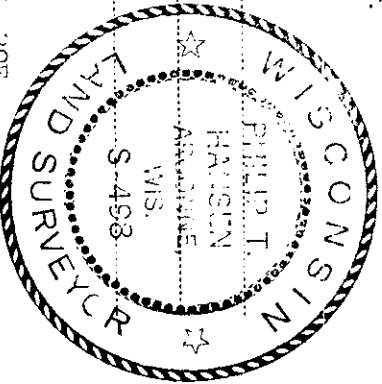

○ = Corner monument restored.

History of original corner establishment: Corner established by St. Regis Surveyors, Goddard and Drivas in 1961. Ran a random line west, bearing 272° 40' mag. from previously established E 1/4 a distance of 89.92 chains closing out 29 lks north of N 1/4 corner. Corrected bearing N 87° 31' W. Set iron pipe at 67.18 chains and 21.6 lks south. Marked Maple 5" N 33° E 24 lks. Maple 4" N 63° W 11 1/2 lks.

Description of corner evidence found: Recovered 1" iron pipe with aluminum cap stamped. Pipe in fair condition, projecting 18" above ground. Recovered OBT Maple 5" N 33° E (N 43° E) 24 lks, now a 6' stub. Maple 4" (5") N 68° W 11.5 lks, scribbling partly visible. Pipe was without crossbar at base. Could be easily extracted. 37 1/16
2120
4300

Description of monument and accessories I established to perpetuate the original location of this corner. Left 1" iron pipe in place, extracted it from ground and put a cross bar base and reset pipe, added to stamping on cap. OBT. Maple 5" N 33° E 24 lks. Scribbled 1/16 ST. 37 1/16
2120
4300

Dated at Rhinelander, Wis., this 29th day of June, 1976

Signature Phillip T. Hansen Title Registered Land Surveyor Registration No. 3-498
 County Surveyor, Registered Land Surveyor, or other duly authorized official

Office of Register of Deeds, County of Oneida 23rd day of July
 Instrument was filed in this office for record on the 10:00 o'clock P. M. I hereby certify that the within

at 10:00 o'clock P. M. Dorice Verage Kuehn
 (Register of Deeds)

By: _____ Deputy

3709202030