

CERTIFIED LAND CORNER RESTORATION

Index No. 0-9

State of Wisconsin



County of Oneida } ss.

I Phillip P. Hansen, do hereby certify that on the 25th day of August, 1979, I found evidence of the 1/16 corner of section 20 - 21 Township 37 North, Range 9 East, Fourth Principal Meridian, as described hereon; and that from this evidence I established a new monument and accessories as described hereon to perpetuate the original location of this corner.

Resident witnesses:

Jim Clafflin

Harb Larson

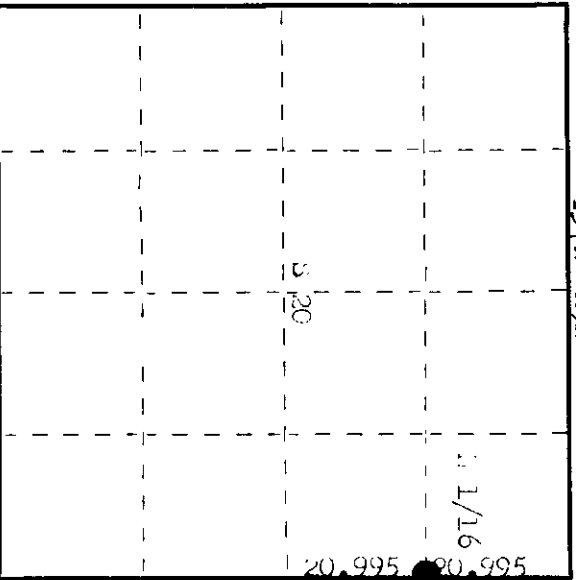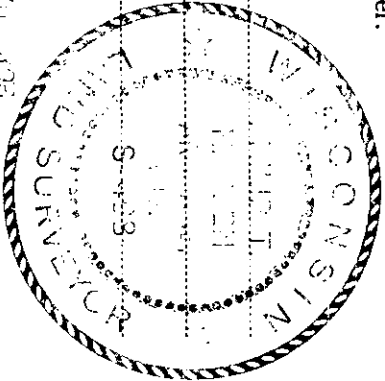

○ = Corner monument restored.

History of original corner establishment:

Corner established by J. Loftus, Mingo surveyor, in 1901. Ran random line from NW 1/4 corner 41.59 chains, closed out 50.11 links east of NW section corner. Recovered bearing to S 37° E. Set 1/16 at 20.995 chains on line, equidistant and marked BT - Spruce 3" x 60 - 25 1/2 links.


Description of corner evidence found:

Recovered 1" iron pipe with alloy cap. Also a 1 1/2" wide iron about 5' long setting beside iron pipe. Cap stamped. Recovered BT - black spruce 3" x 60 - 25.5 links, scribed 1/16 BT. Tree is now dead.



Description of monument and accessories I established to perpetuate the original location of this corner.

Removed 1" iron pipe from ground, installed a cross bar at bottom end reset in same hole. Added additional scribbling to cap. Set angle iron beside iron pipe. Monument projects 20" above ground. BTs - black spruce 4" x 54 - 24.8 links, scribed BT. Black spruce 4" x 40 - 15.1 links, scribed BT. Monument and BTs painted blue.

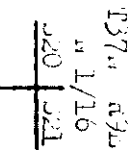

Dated at Oneida, Wis., this 10th day of August, 1979.

Signature Phillip P. Hansen, Title Registered Land Surveyor, Registration No. 2-478 (County Surveyor, Registered Land Surveyor, or other duly authorized official)

Office of Register of Deeds, County of Oneida. I hereby certify that the within instrument was filed in this office for record on the 22nd day of August, 1979 at 1:20 o'clock P. M.

Terrie Heritage-Fischer (Register of Deeds)

By Phillip P. Hansen Deputy

370920 3000