

CERTIFIED LAND CORNER RESTORATION


Index No. **0-8**

State of Wisconsin

County of Oneida } ss.

I, Phillip F. Hansen, do hereby certify that on the 25th day of August, 1976, I found evidence of the W. 1/16 corner of the Section 20 Township 37 North, Range 9 East, Fourth Principal Meridian, as described hereon; and that from this evidence I established a new monument and accessories as described hereon to perpetuate the original location of this corner.

Resident witnesses:  
Jim Staffin  
Herb Jagoner

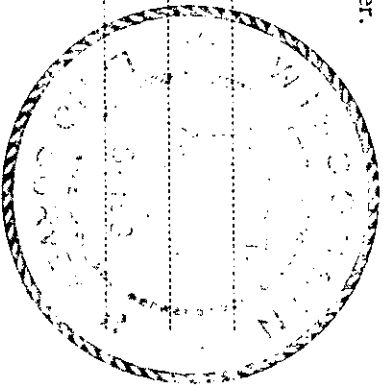


History of original corner establishment: Corner established by W. Loftus, arco curve of, in 1901. From re-established  $\frac{1}{16}$  corner on north line ran a random line bearing  $184^{\circ} 30'$  and  $40.85$  chains, closed out  $37$  links east of  $184^{\circ} 30'$  corner. Set a  $\frac{1}{16}$  corner at  $20.425$  chains,  $182$  links west and marked red line  $14''$   $\curvearrowright$   $300$   $\curvearrowright$   $466$  links and white pine  $8''$   $\curvearrowright$   $530$   $\curvearrowright$   $58$  links.

Description of corner evidence found:  
 recovered  $3/4''$  iron pipe with alloy cap stamped W 1/16 NW. monument was recovered in good condition, but could be pulled out of ground easily.

recovered bolts - red pine  $14''$  ( $15''$ )  $\curvearrowright$   $300$   $\curvearrowright$   $40.5$  links, secured W 1/16 NW.  
 white pine  $8''$  ( $10''$ )  $\curvearrowright$   $530$   $\curvearrowright$   $58.0$  links, secured W 1/16 NW.  
 Distances measured to center of brass.

Description of monument and accessories I established to perpetuate the original location of this corner.  
 removed iron pipe from ground, installed a crossbar at base and reset in same hole.  
 added stamping to cap, now stamped:  
 monument projects  $20''$  above ground.  
 monument and ST's painted blue.

1976 NW  
 W 1/16  
 +  
 520  
 NW

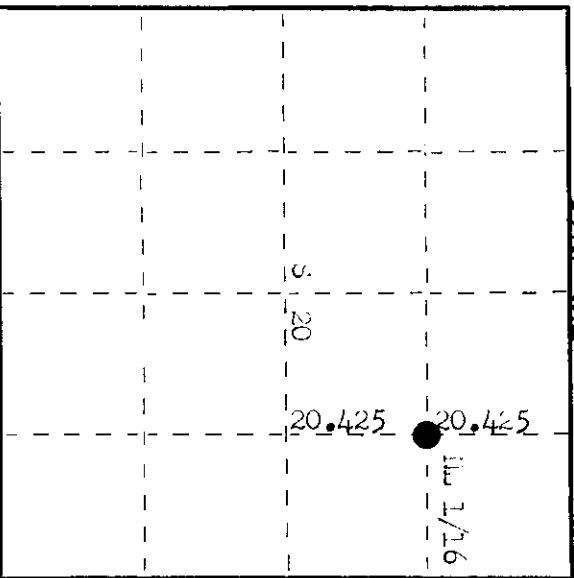

○ = Corner monument restored.

Dated at Rhineland, Wis., this 10th day of September, 1976.

Signature Phillip F. Hansen Title Registered Land Surveyor Registration No. 4498  
 (County Surveyor, Registered Land Surveyor, or other duly authorized official)

Office of Register of Deeds, County of Oneida gch day of November, 1976.  
 I hereby certify that the within instrument was filed in this office for record on the 14th day of October, 1976, at 4:30 o'clock A. M.

Debra Terage-Richard  
 (Register of Deeds)

By Debra Terage-Richard Deputy

3709203010