

CERTIFIED LAND CORNER RESTORATION

Index No. **0-7**

State of Wisconsin




I Phillip T. Jansen do hereby certify that on the 14th day of April, 1976, I found evidence of the NC 1/16 corner of the Section 20 Township 37, North, Range 9 East, Fourth Principal Meridian, as described hereon; and that from this evidence I established a new monument and accessories as described hereon to perpetuate the original location of this corner.

Resident witnesses:

Glenn Barker

Jim Glarkin

Herb Janner

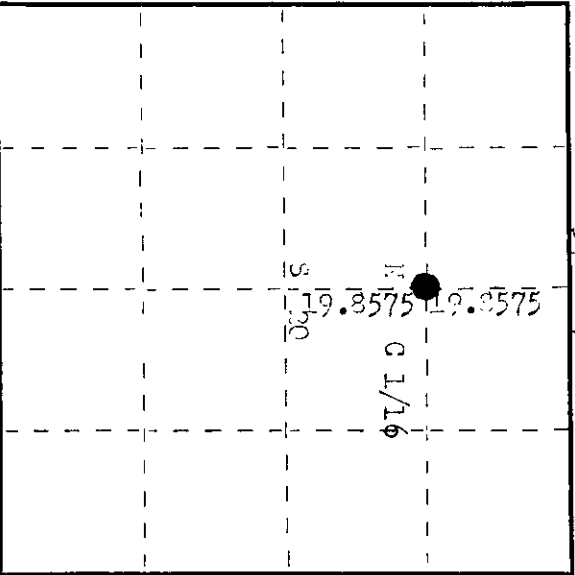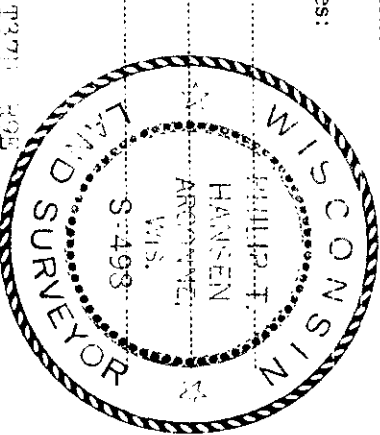


○ = Corner monument restored.

CERTIFIED LAND CORNER RESTORATION


Index No. **0-7**

History of original corner establishment: Corner originally established by D.H. Vaughan, County Surveyor, Re-established by St. Regis Surveyors, Goddard and Dunning, in 1961. Put a random line North from S 1/4 corner 79.605 chains to point 4.04 lks East of North 1/4 corner. Set a 1/4 corner at 38.80 chs and NC 1/16 at 58.74-3/4 ch lks West. Marked with a W. Pine 6" in 150 ft 521 lks. W. Pine 10" in 600 ft 572 lks.

Description of corner evidence found: Recovered 1" iron pipe with aluminum cap stamped. Pipe projects 10" above ground. Recovered ORP - W. Pine 6" in 150 ft 52.5 lks, scribed ON 1/4 E RP. W. Pine 10" in 600 ft (3790 ft) 57.5 lks, scribed ON 1/4 E RP.

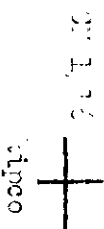

Description of monument and accessories I established to perpetuate the original location of this corner. as pipe was recovered in good condition, it was left in place. added new string to cap. no additional accessories established.

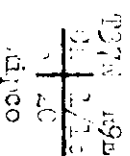


(County Surveyor, Registered Land Surveyor, or other duly authorized official)


Doree Verage Kuehn  
(Register of Deeds)

By: Deputy

3709203020