

CERTIFIED LAND CORNER RESTORATION

Index No. **0-6**

State of Wisconsin



County of Oneida } ss.

I, Phillip W. Hansen, do hereby certify that on the 26th day of August, 1975, I found evidence of the N 1/16 corner of section 20 Township 27, North, Range 9 East, Fourth Principal Meridian, as described hereon; and that from this evidence I established a new monument and accessories as described hereon to perpetuate the original location of this corner.

Resident witnesses:

Jim Clafflin


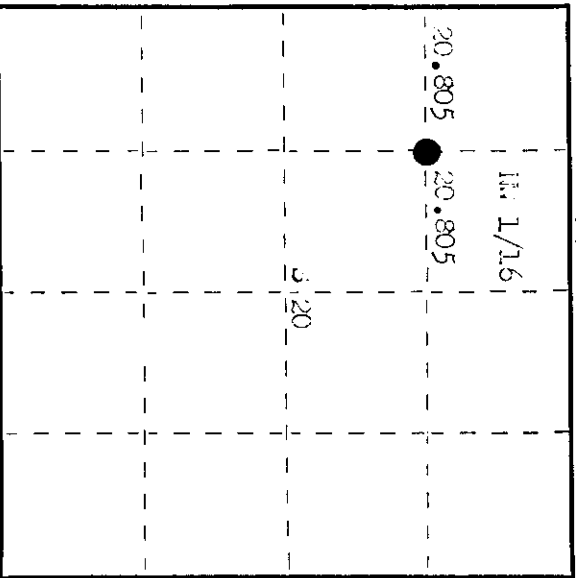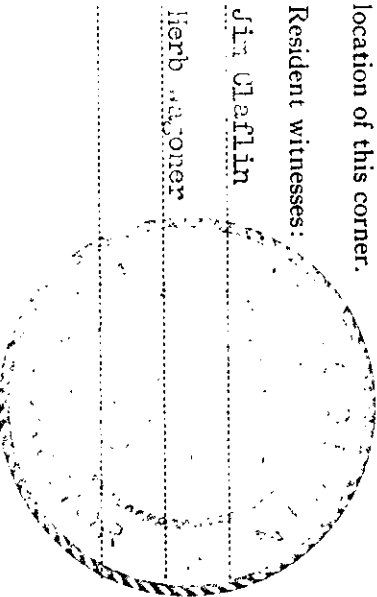

○ = Corner monument restored.

History of original corner establishment:

Corner established by M. Loftus, Rego surveyor, in 1961. From re-established N 1/16 corner, we ran a random line west, bearing 272° 30' magnetic, 47.61 chains, closed out 82 1/2 links south of N 1/16 corner between sec. 19 and 20. Set N 1/16 at 23.805 chains, equidistant 4 1/4 links north. Marked WPI's - cedar 4" 85° 15 links and Tamarack 5" 87° 31 1/2 links. Corrected bearing is 86° 30' "

Description of corner evidence found:

Recovered 1" WD iron pipe with alloy cap stamped N 1/16 S20 R9E. Also recovered 3" cedar post, squared and scribed N 1/16 S20 N 1/16 S20.

Recovered WPI's - cedar 4" (3") 85° 15.0 links, scribed N 1/16 S20. Tamarack 5" (6") 87° 31.5 links, scribed N 1/16 S20.

Iron pipe was easily pulled out of ground.

Description of monument and accessories I established to perpetuate the original location of this corner. removed iron pipe and installed cross bar at base. reset pipe in same location. added stamping to cap. monument projects 20" above ground. monument and WPI's painted blue.



Dated at rhinelander, Wis., this 10th day of September, 1976

Signature Wm. S. ... Title registered land surveyor Registration No. 3-498
(County Surveyor, Registered Land Surveyor, or other duly authorized official)

Office of Register of Deeds, County of Oneida 9th day of November, 1975
at 3:00 o'clock P. M.

Terrie Verage Kuehn
(Register of Deeds)

By: _____ Deputy

3709203030