

CERTIFIED LAND CORNER RESTORATION

Index No. **Q-13**

State of Wisconsin

County of Oneida } ss.



I Philip T. Hansen, do hereby certify that on the 26th day of August, 1977, I found evidence of the S. 1/16 corner of Section 21 & 22 Township 37 North, Range 9 East, Fourth Principal Meridian,

as described hereon; and that from this evidence I established a new monument and accessories as described hereon to perpetuate the original location of this corner.

Resident witnesses:

Jim Claffin

Herb Hagoner

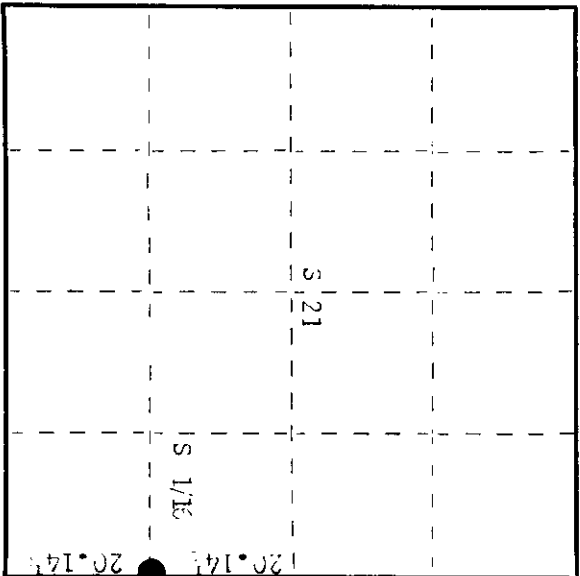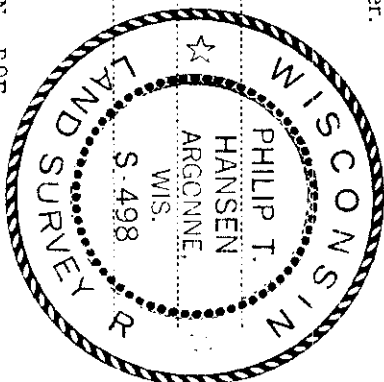

○ = Corner monument restored.

History of original corner establishment:

Corner established by N. Loftus, Ripco Surveyor, in 1958. Ran random line south (176° 30' mag.) 40.29 chains to close out 41 links west of section corner. Set S 1/16 at 20.14 chains and marked Bts - Red Maple 5" 576<sup>0</sup>/<sub>4</sub> 251 links White Birch 4" 224<sup>0</sup>/<sub>E</sub>, 12 links

Description of corner evidence found:

Recovered 1" iron wire with 2" brass cap projecting 2" above ground. Monument in good condition with large rock cairn around it. Cap stamped: Recovered Red Maple 5" 576<sup>0</sup>/<sub>4</sub> (591<sup>0</sup>/<sub>W</sub>) 25.25 links,

scribed 1/16 S21 BT  
White Birch 4" 224<sup>0</sup>/<sub>E</sub>, 12.0 links (12.0 links),  
scribed 1/16 S22 BT. This BT now dead.

S 1/16  
S21 | S22  
BTCC

Description of monument and accessories I established to perpetuate the original location of this corner.

Monument left as recovered. Marked Bt - Maple 6" N22<sup>0</sup>/<sub>E</sub>, 20.3 links, scribed 1/16 BT.

Dated at Rhineland, Wis., this 9th day of September, 1977.

Signature: *Philip T. Hansen* Title: Registered Land Surveyor Registration No. S-498  
County Surveyor, Registered Land Surveyor, or other duly authorized official

Office of Register of Deeds, County of Oneida. I hereby certify that the within instrument was filed in this office for record on the 15th day of September, 1977, at 2:00 o'clock P.M.

Signature: *John Pennington* Title: Register of Deeds  
(Register of Deeds)

By: Deputy

3709211000