

CERTIFIED LAND CORNER RESTORATION

Index No. R-21

State of Wisconsin } ss.
County of Oneida


History of original corner establishment:
Original corner established by Wm. E. Dougherty, Deputy Surveyor, in 1863 from which Birch 8" bears N62°E 13 links; Birch 12" bears S41°E 17 links. N. Loftus, Ripco surveyor, set a 2" iron pipe with brass cap in 1956.

I Phillip T. Hansen, do hereby certify that on the 10th day of June, 1980, I found evidence of the Section Corner corner of Sections 23, 24, 25, 26 Township 37, North, Range 9 East, Fourth Principal Meridian, as described hereon; and that from this evidence I established a new monument and accessories as described hereon to perpetuate the original location of this corner.

Description of corner evidence found:
Recovered 2" iron pipe with 4" brass cap, stamped:
Monument projects 18" above ground.
Recovered OBT's -
B. Spruce 5" N29°E 16.7 links,
now dead - scribed S24-BT.
Tamarack 4" S89°W 26.5 links,
now dead - scribed S26-BT.
(not recorded)

T37N R9E
S 23 + 24
26 + 25

Resident witnesses:
Jim Clafflin
Herb Wagoner

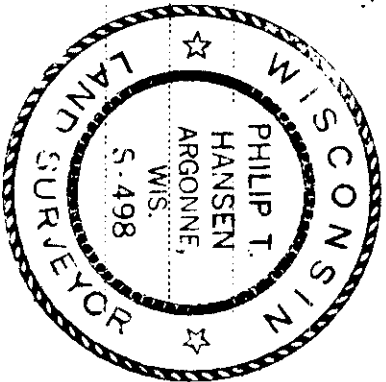


Description of monument and accessories I established to perpetuate the original location of this corner.

Monument left as recorded.

Marked NBT's -

- Tamarack 7" S13°W 66.0 links
- B. Spruce 6" S22°E 41.2 links
- Tamarack 5" N76°E 20.6 links
- Tamarack 6" West 67.8 links
- scribed S.C. B.T.

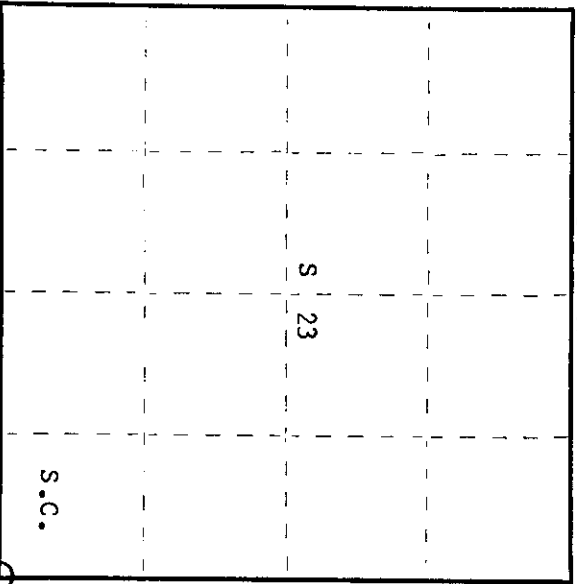

○ = Corner monument restored.

Dated at Rhineland, Wis., this 22nd day of July, 1980.

Signature: Phillip T. Hansen Title: Registered Land Surveyor Registration No. S-498
(County Surveyor, Registered Land Surveyor, or other duly authorized official)

Office of Register of Deeds, County of Oneida. I hereby certify that the within instrument was filed in this office for record on the 30th day of July, 1980 at 10:15 o'clock A.M.

Terrie Savage Kuehn
(Register of Deeds)

By: _____ Deputy

3709230000