CERTIFIED LAND CORNER RESTORATION

Index No. Q-20

3709231010

State of Wisconsin } ss.
County of Oneida

I Philip T. Hansen, do hereby certify that on the 22nd day of February, 1977, I found evidence of the SE 1/16 corner of Section 23 Township 37, North, Range 9 East, Fourth Principal Meridian, as described hereon; and that from this evidence I established a new monument and accessories as described hereon to perpetuate the original location of this corner.

Resident witnesses:

Jim Claflin

Herb Wagoner

WISCONSIN PHILIP T. HANSEN LAND SURVEYOR

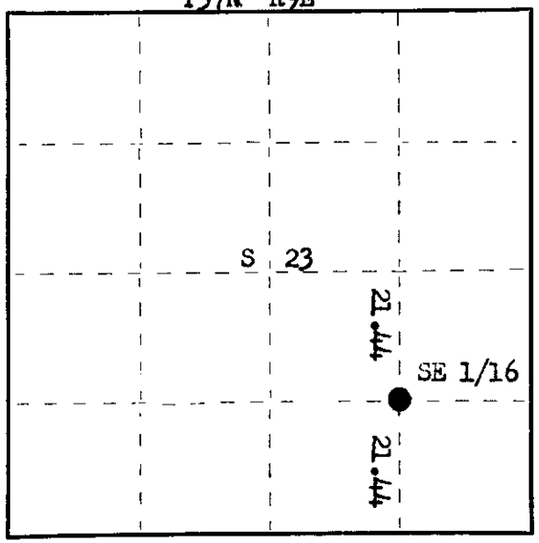

○ = Corner monument restored.

History of original corner establishment:

Corner established by N. Loftus, Ripco Surveyor, in 1958. Ran random line south bearing 176° 30' mag. from EC 1/16 corner 42.88 chains to close out 63½ links east of E 1/16 between Section 23 and 26. Set SE 1/16 corner at 21.44 chains, 31.75 links west intermediate. Marked NBTs - Birch 4" S39°W, 54 links; Pine 24" S53°E, 1.20 chains.

Description of corner evidence found:

Recovered 1" iron pipe with alloy cap. Stamped:
Monument recovered in good condition.
Recovered OBTs - White Birch 4" (6") S39°W (S43°W) 54.0 links (52.8 lks.)
White Pine 24" (28") S53°E 1.20 chains, scribing grown over.

SE 1/16 + S23
RIPCO

Description of monument and accessories I established to perpetuate the original location of this corner.

As the monument was recovered in good condition, it was left in place.
Added stamping T37N R9E to alloy cap.
Monument projects 24" above ground.

Dated at Rhinelander, Wis., this 29th day of March, 1977

Signature Philip T. Hansen Title Registered Land Surveyor Registration No. S-498
(County Surveyor, Registered Land Surveyor, or other duly authorized official)

Office of Register of Deeds, County of Oneida, I hereby certify that the within instrument was filed in this office for record on the 1st day of April, 1977 at 2:00 o'clock P. M.

Doris Verage Kuehn
(Register of Deeds)

By ..... Deputy

FORM 985 H. C. MILLER CO., MILWAUKEE