

CERTIFIED LAND CORNER RESTORATION

Index No. Q-19

State of Wisconsin

County of Oneida } ss.


I Phillip T. Hansen, do hereby certify that on the 22nd day of February, 19 77, I found evidence of the SC 1/16 corner of the Section 23 Township 37, North, Range 9 East, Fourth Principal Meridian,

as described hereon; and that from this evidence I established a new monument and accessories as described hereon to perpetuate the original location of this corner.


Resident witnesses:

Jim Clavin

Herb Wagoner

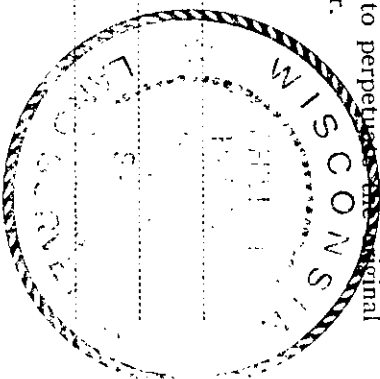

T37N R9E

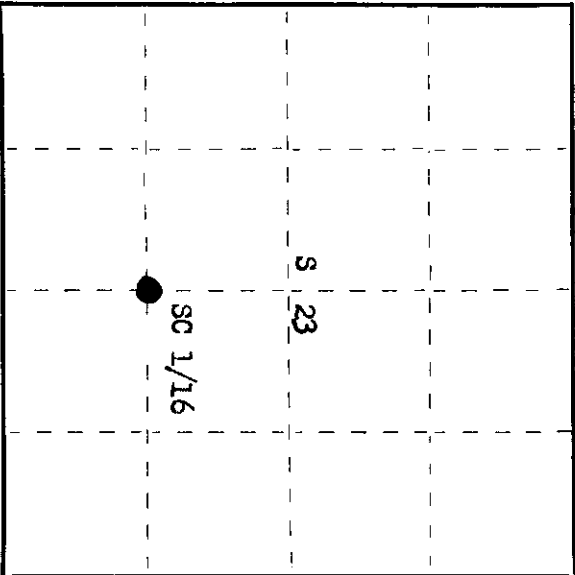

○ = Corner monument restored.

History of original corner establishment:

Corner established by N. Loftus, Ripco Surveyor, in 1955. Ran a random line N 1° 30' W from S 1/4 corner, 42.435 chains to close out 20 links west of recovered C 1/4 corner. Set the SC 1/16 corner at 21.2175 chains 10 links east. No record of any corner previously established. Set iron pipe, but no record of any BTS established.

Description of corner evidence found:

- Recovered 1" iron pipe with 2" square brass cap stamped: Monument found in good condition.
- Recovered a 5" cedar post, squared and scribed 1/16 - 1/16 beside it. S 1/16
- Recovered OBTS - Maple 7" SW 26.8 links, scribing not legible. C
- Maple 7" NW SE 11.0 links, scribing not legible. RIPCO

Description of monument and accessories I established to perpetuate the original location of this corner.

As monument was recovered in good condition, it was left in place. Added stamping T37N R9E to brass cap. Monument projects 30" above ground.

Dated at Rhinelander, Wis., this 29th day of March, 19 77.

Signature Phillip T. Hansen Title Registered Land Surveyor Registration No. S-498
(County Surveyor, Registered Land Surveyor, or other duly authorized official)

Office of Register of Deeds, County of Oneida, I hereby certify that the within instrument was filed in this office for record on the 5th day of May, 19 77 at 2:00 o'clock P. M.

Verne Donagan Kuehn
(Register of Deeds)

By _____ Deputy

3709 231020