

CERTIFIED LAND CORNER RESTORATION



Index No. P-20

State of Wisconsin

County of Oneida } ss.

I, Phillip T. Hansen, do hereby certify that on the 12th day of June, 1980, I found evidence of the EC 1/16 corner of Section 23 Township 37, North, Range 9 East, Fourth Principal Meridian, as described hereon; and that from this evidence I established a new monument and accessories as described hereon to perpetuate the original location of this corner.

Resident witnesses:
Jim Clafflin
Glen Barker

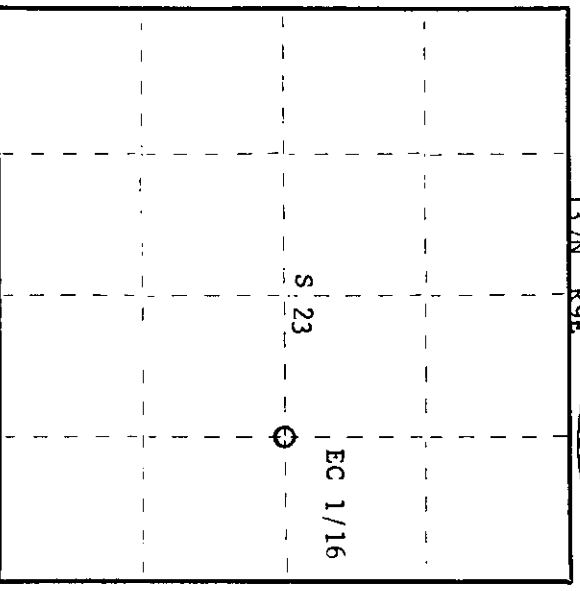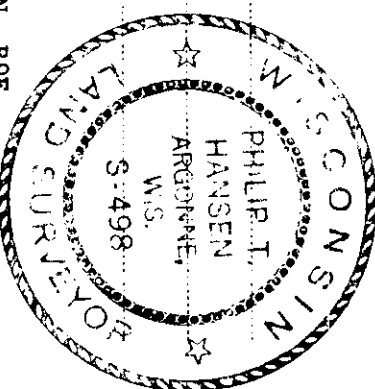

○ = Corner monument restored.

History of original corner establishment:

No records of any previous surveys. Corner established by N. Loftus, Ripco surveyor. Ran line north from E 1/16 between sections 23 and 26. Recovered an old axe handle with white birch BT and pine BT. Set a 3/4" iron pipe with rock cairn around base. Also a rock ring around remains of white birch BT.

Description of corner evidence found:

Recovered Ripco's 3/4" iron pipe with 2" brass cap, in good condition, small rock cairn around base.
Recovered white pine BT 15" S63°W 21.0 links, scribed 1/8 (not Ripco's).
Monument projects 12" above ground, cap stamped:

E 1/16
C ——— C
S23
RIPCO

Description of monument and accessories I established to perpetuate the original location of this corner.
Left monument in place as recovered.
Marked NBT's - Maple 5" N36°E 23.5 links
Maple 7" S9°E 23.3 links
both scribed 1/16 BT.

Dated at Rhineland, Wis., this 21st day of July, 1980

Signature Phillip T. Hansen, Title Registered Land Surveyor, Registration No. S-498
(County Surveyor, Registered Land Surveyor, or other duly authorized official)

Office of Registrar of Deeds, County of Oneida, I hereby certify that the within instrument was filed in this office for record on the 30th day of July, 1980 at 10:12 o'clock P. M.

Doris Venage Kuehn
(Registrar of Deeds)

By: _____ Deputy

3709232010