

U.S. PUBLIC LAND SURVEY MONUMENT RECORD


Note: This form is intended and designed to fulfill all requirements of Wisconsin Administrative Code, Chapter A-E 7.08 U.S. Public Land Survey Monument Record (3) (a) (b) (c) (d) (e) (f) (g) (h) (i). An additional sheet may be added if necessary to conform with said requirements.

(a) Corner location: Township 37 North

Range 10 East/West

Town/City/Village Stella

County Oneida

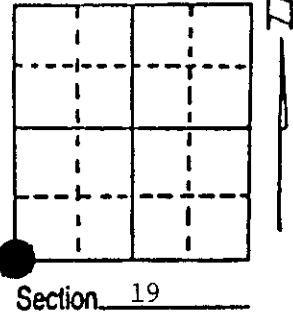

(b) (f) (g) (h) Description of monument found at this corner and if it was accepted, state all evidence (material, testimonial, occupational, plats, records, other monuments) used as a basis for accepting. If not accepted or if nothing was found, state evidence used as basis for establishing location. If re-established through lost corner proportionate methods, indicate all monuments, distances and directions used to establish. Indicate type of monument found or set and sign post.

July 1859 - H. C. Fellows established this corner and set a wood post:

- | | |
|-----------------------------|-----------------------------|
| 7" Y. Pine, N84°E, 32 links | 7" Y. Pine, S32°W, 43 links |
| 18" Birch, S48°E, 25 links | 8" W. Pine, N18°W, 22 links |

1933 - County Surveyor Hall restored corner and set a 6" x 6" concrete monument with brass cap stamped to identify the corner.

1953 - B.L.M. located Hall corner and accepted it for the true corner position and set three new BTs:


- 12" Red Pine, N22½°E, 26 links (17.16')
- 5" Red Maple, S55 1/4°W, 64 links (42.24')
- 9" Red Pine, N30 1/2°W, 27 links (17.82')

3/21/89 - Milo E. Stefan found Hall's corner and B.L.M.'s BTs in excellent condition. Made one new BT and placed plastic sign post.

(c) (d) (e) Plan view of corner with ties to at least 4 witness monuments. If in disagreement with previously established corner, show the distances between the two corners and also indicate the ties to the disputed corner.

1. 6" x 6" concrete monument/brass cap
2. 16" Red Pine, N22 1/2°E, 16.90'
3. 7" Red Pine, S49°E, 23.42'
4. 10" Red Maple, S55 1/4°W, 42.56'
5. 14" Red Pine, N30 1/4°W, 17.91'
6. Plastic sign post next to monument

Distances to nail in side of BTs.
BT's scribed "BT" in stump blaze.

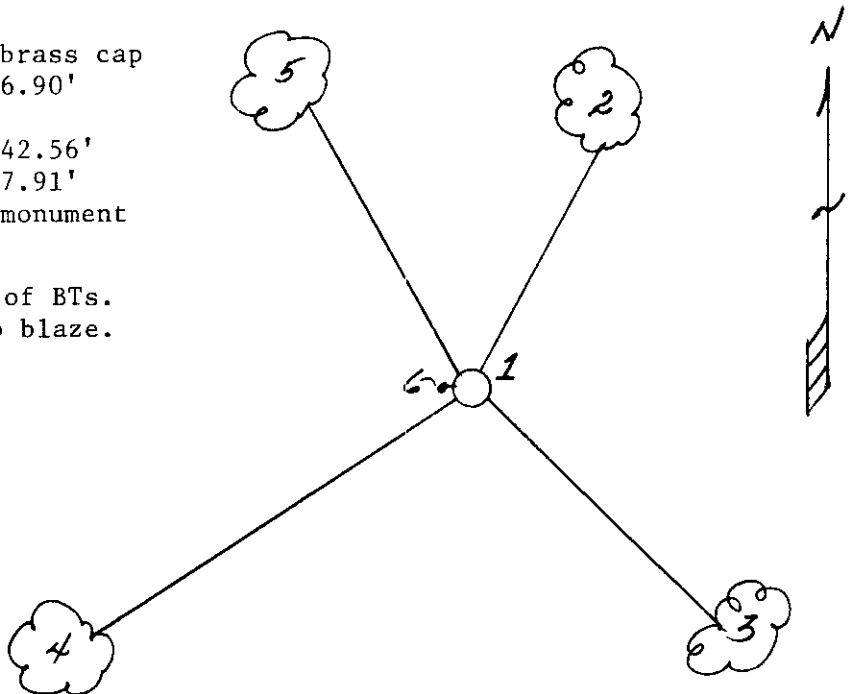

(i) I, Milo E. Stefan
(type or print name) certify that the corner location on this record was determined by me or under my direction and control and that this U.S. Public Land Survey Monument Record is correct and complete to the best of my knowledge and belief.

Milo E. Stefan
Signature

March 28, 1989
Date



Index No. R-1

3709240000