

CERTIFIED LAND CORNER RESTORATION

Index No. P-1


State of Wisconsin }  
County of Oneida } ss.

I, Philip T. Hansen, do hereby  
certify that on the 26th day  
of June, 1977, I found  
evidence of the Quarter  
corner of 24 & 19  
Township 37, North, Range  
9 & 10 East, Fourth Principal Meridian,  
as described hereon; and that from this evidence  
I established a new monument and accessories  
as described hereon to perpetuate the original  
location of this corner.


Resident witnesses:

Jim Claflin

Herb Wagoner

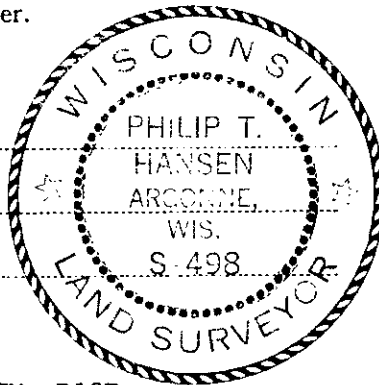

T37N R10E

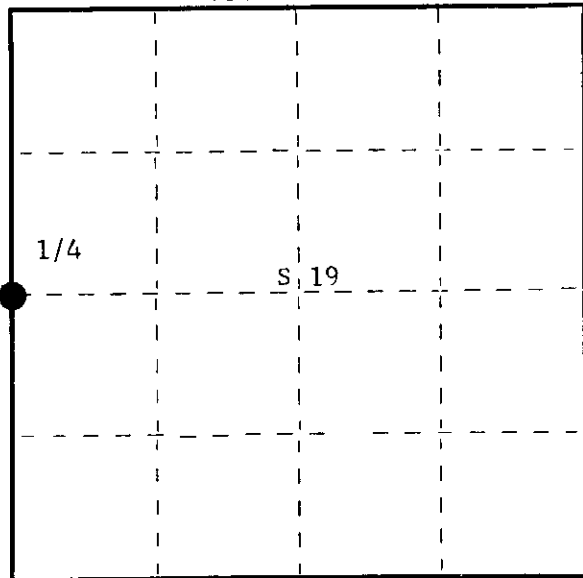

○ = Corner monument restored.

History of original corner establishment:

Original Corner established by Hiram Fellows, Deputy Surveyor, in 1860 from which White Pine 10" bears N54°E, 22 links and Yellow Pine 6" bears S66°W, 3 links.

N. Loftus, Ripco Surveyor, recovered an old 1/4 post in 1956 at 39.96 chains S2°25' E, origin unknown. Set iron pipe and marked NBTs - Cedar 8" S49°E, 30 links  
Cedar 7" N31°E, 55 links

Description of corner evidence found:

Recovered 1-3/4" iron pipe with 4" square brass cap.  
Corner sets on top of a steep hill on east side of Roosevelt firelane.  
Monument projects 32" above ground. Cap stamped:  
No evidence of BTs visible.

T37N  
R9E R10E  
1/4  $\frac{24}{19}$   
RIPCO

Description of monument and accessories I established to perpetuate the original location of this corner.

Monument was left as recovered.  
Marked NBTs - White Birch 6" N12°W, 39.4 links, scribed 1/4 BT.  
Red Pine 20" S68°E, 178.9 links, scribed 1/4 BT.

Dated at Rhineland, Wis., this 29th day of June, 1977

Signature Philip T. Hansen Title Registered Land Surveyor Registration No. S-498  
(County Surveyor, Registered Land Surveyor, or other duly authorized official)

Office of Register of Deeds, County of Oneida, I hereby certify that the within  
instrument was filed in this office for record on the 8<sup>th</sup> day of July, 1977  
at 1:30 o'clock P M.

Doris Verage Kuehn  
(Register of Deeds)

By Joseph M. Boomer Deputy

FORM 985

3709242000