U.S. PUBLIC LAND SURVEY MONUMENT RECORD

Note: This form is intended and designed to fulfill all requirements of Wisconsin Administrative Code, Chapter A-E 7 08 U.S. Public Land Survey Monument Record (3) (a) (b) (c) (d) (e) (f) (g) (h) (i). An additional sheet may be added if necessary to conform with said requirements.

(a) Corner location: Township 37 North

Range 9 East/~~West~~

Town/~~City/Village~~ Pine Lake

County Oneida

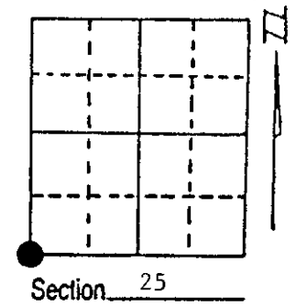

(b) (f) (g) (h) Description of monument found at this corner and if it was accepted, state all evidence (material, testimonial, occupational, plats, records, other monuments) used as a basis for accepting. If not accepted or if nothing was found, state evidence used as basis for establishing location. If reestablished through lost corner proportionate methods, indicate all monuments, distances and directions used to establish. Indicate type of monument found or set and sign post.

1863 - William Daugherty established this corner and set a wood post with BTs:
10" Birch, S58°W, 17 Links 10" Aspen, N74°E, 32 Links

8/2/89 - Milo E. Stefan found corner marked with a 2" x 24" iron pipe with 3" x 3" x 5' scribed post along side. No original survey evidence remains. Perpetuation of the corner position is strong as this corner is accepted by owners in area. BTs have been made 30 - 50 years ago.
I accept this iron pipe as the perpetuated corner position and restore same by placement of an aluminum county monument, making new BTs and placing a plastic sign post.

6/1/1903 - Vaughan was here and made a new reference, a 11" Red Pine stump, S87°E, 78½ lks.

10/4/1936 - Maine found and iron pipe , set a cedar stake for corner with two new BT's:
9" Red pine, N35°E, 1.04 chains 8" Red pine, N85°W, 78 3/4 links

(c) (d) (e) Plan view of corner with ties to at least 4 witness monuments. If in disagreement with previously established corner, show the distances between the two corners and also indicate the ties to the disputed corner.

1) 2" x 30" aluminum county monument
* 2) 18" Red Pine, N27°E, 68.44'
** 3) 12" Red Pine Stump, S83°E, 51.60'
4) 10" Red Pine, S77°E, 65.36'
* 5) 14" Red Pine, N84°W, 50.40'
6) 8" Red Pine, N8°W, 51.04'
7) Plastic sign post, SE, .4'

Distances to nail in side of BTs.
BTs scribed "BT" in stump blaze.
* BT by Maine - 1936
** BT by Vaughan - 1903

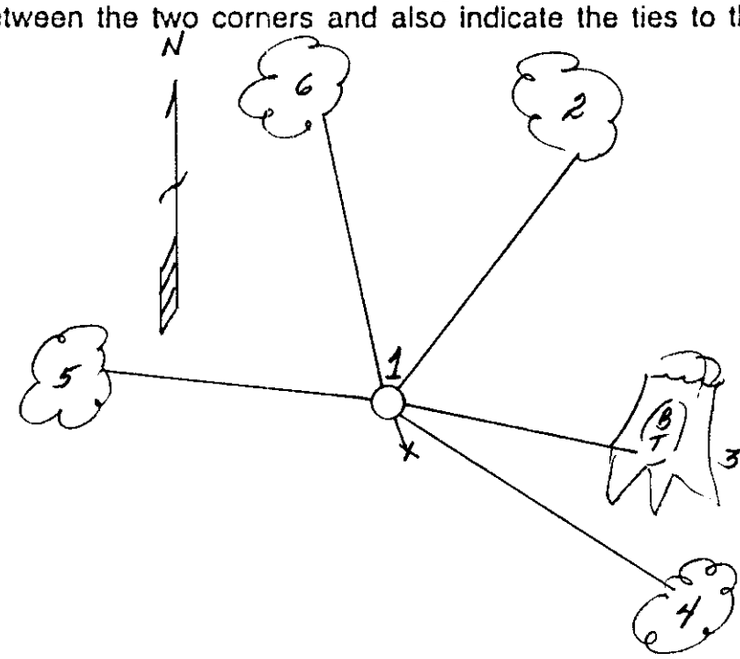

(i) I, Milo E. Stefan
(type or print name) certify that the corner location on this record was determined by me or under my direction and control and that this U.S. Public Land Survey Monument Record is correct and complete to the best of my knowledge and belief.

Milo E Stefan 8/5/89
Signature Date

WISCONSIN
MILO E. STEFAN
S-1558
RHINELANDER, WIS.
LAND SURVEYOR

Index No. V-21

3709260000