

CERTIFIED LAND CORNER RESTORATION

Index No. U-15

State of Wisconsin }
County of Oneida } ss.


History of original corner establishment:
Corner established by Genisot Associates, Inc.

I, Philip T. Hansen, do hereby
certify that on the 19th day
of July, 1977, I found
evidence of the SC 1/16
corner of Section 27
Township 37, North, Range
9 East, Fourth Principal Meridian,
as described hereon; and that from this evidence
I established a new monument and accessories
as described hereon to perpetuate the original
location of this corner.

Description of corner evidence found:
Recovered 1" iron pipe 20" long, driven into ground flush with surface.
Recovered OBTs - White Birch 8" S50°W, 40.1 ft. (61) links.
White Birch 4" S0° 30' W, 26.2 feet - scribed 1/16 BT (down and dead).


Resident witnesses:

Jim Claflin
Herb Wagoner

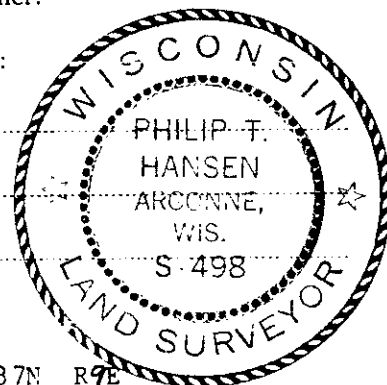

Description of monument and accessories I established to perpetuate the original location of this corner.
Replaced iron pipe with 1" iron pipe with 2" brass cap, stamped:
NBT - Maple 6" S10°W, 10.7 links, scribed 1/16 BT.
Monument projects 20" above ground.

T37N R9E
SC 1/16 S²⁷
S498-1977

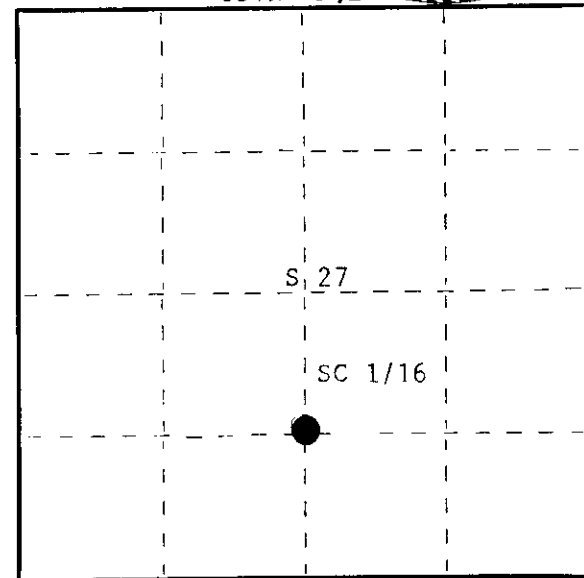

○ = Corner monument restored.

Dated at Rhineland, Wis., this 28th day of July, 1977.

Signature Philip T. Hansen Title Registered Land Surveyor Registration No. S-498
(County Surveyor, Registered Land Surveyor, or other duly authorized official)

Office of Register of Deeds, County of Oneida, I hereby certify that the within
instrument was filed in this office for record on the 5th day of August, 1977
at 9:00 o'clock a M.

Doris Verage Kuehn
(Register of Deeds)

By _____ Deputy

FORM 983 H. G. MILLER CO. MILWAUKEE

0201271070