

This form is intended to fulfill requirements of Chapter A-E 7.08 (3)(a) thru (i) U.S. Public Land Survey Monument Location Record, Wisconsin Administrative Code. Use reverse side for geodetic location data and/or other continuation purposes.

U.S. PUBLIC LAND SURVEY MONUMENT LOCATION RECORD

Recorders Data

USPLS CORNER: WEST 1/4 CORNER SECTION: 26 TOWNSHIP: 37 NORTH RANGE: 9 EAST

NAME OF WATERWAY FOR M.C. CORNER: N/A SECTION LINE: N/A

(CITY)(VILLAGE)(TOWN) OF: PINE LAKE COUNTY OF: ONEIDA

Description of monument found or placed and all other evidence used as the basis for monument location; including monuments and related measurements required if the corner location was reestablished by lost corner proportionate methods. Also indicate name of original surveyor, original survey date and the corner monument, bearing trees, witness or other reference monuments established; including measured bearing and distance ties, from available records.

Found and accepted rusting yellow painted 2" dia. iron pipe monument with 1/4" by 4" square RIPCO stamped steel plate cap 33" above existing grade at this corner location. I sawed off upper 27" of the older iron pipe monument and drove a standard 2" dia. by 30" long aluminum pipe monument with stamped Oneida County cap over the remaining 6" high stub of old iron pipe. I left sawed off old iron pipe and pieces of probable old wood corner post found nearby flat on grade next to new monument set. Corner is accessible via driveway to Fire No. 4296 from Sheppard Lake Road.

In 1863, William Daugherty/GLO set a wood post as the original corner and marked OBTs, a 12" Aspen N37°W 17 links and an 8" Bw S41°E 19 lks, all of which are now obliterated and/or indeterminate for locational purposes.


In 1894, B.F. Dorr, noted a post at corner and new BTs, an 18" Py N23°E 19 links and a 16" Py S76.5°E 33 links, all of which are now obliterated and/or indeterminate for locational purposes.

In 1903, Vaughn found Dorr's 4" sq. cedar post and BT 16" Pn N20°E 19 links and noted corner post is 4.50 chains North of Soo Line Railroad tracks.

In 1995, Todd Loftus, RLS 1523 found Ripco capped iron pipe monument previously set by Norman Loftus, RLS 259, per Plat of Survey filed as C-1205 in Oneida County survey records.

This recovery completed May 4, 1999; there were no witnesses.

Plan view map of monument location with bearing and distance ties to a minimum of four(4) described witness or reference monuments of concrete, natural stone, iron, live bearing trees or equivalent material. If applicable, also show a minimum of two(2) bearing and distance ties to any other monument found and not accepted; including the bearing and distance from the accepted monument.

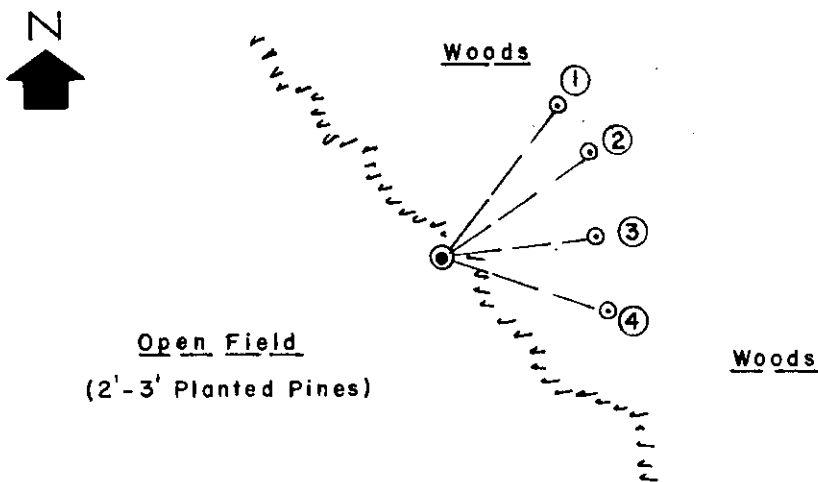

WITNESS MONUMENT TIES:


- 1 New BT 16" Pr N37°E 40.00'.
- 2 New BT 14" Pr N54°E 37.90'.
- 3 New BT 14" Pr, West trunk of twin, N82°E 32.39'.
- 4 New BT 14" Pr S73°E 36.79'.

Standard white poly 'T' marker post set 6" West of corner monument.

SCALE: 1" = 40'

Unless otherwise indicated, all bearing tree ties are to a .25" dia. by 2.5" long PK nail with a 1.25" dia. steel washer driven into unblazed right face and a .25" dia. by 2.5" long PK nail is also driven into unblazed face of bearing tree at DBH; the basis for measured bearings is by magnetic compass to nearest degree and all tie distances are measured horizontal by steel tape corrected to nearest 1/100th feet at standard temperature of 68 degrees Fahrenheit.


RLS SEAL:

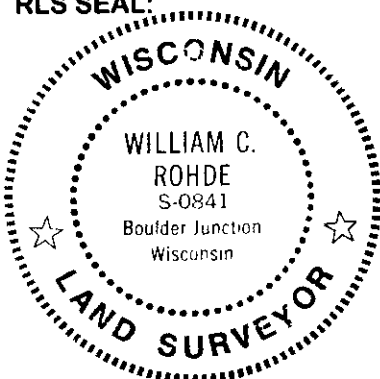

LAND SURVEYOR CERTIFICATE:

I, William C. Rohde, hereby certify that I am duly licensed as a Professional Land Surveyor in the State of Wisconsin; that this USPLS monument location was determined by me and/or under my direct supervision and control; and that this U.S. Public Land Survey Monument Location Record is true and correct to the best of my knowledge and belief.

Signed *William C. Rohde*
William C. Rohde RLS 841

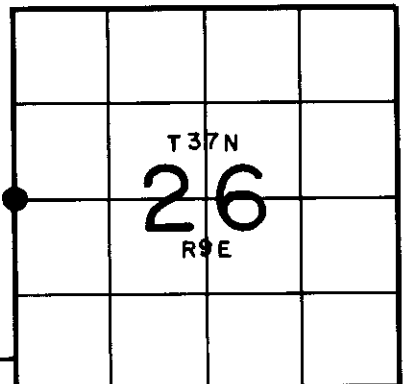

SECTION LOCATION MAP

INDEX NO. T 17

3709 27 20 00