U.S. PUBLIC LAND SURVEY MONUMENT RECORD

Note: This form is intended and designed to fulfill all requirements of Wisconsin Administrative Code, Chapter A-E 5.02, U.S. Public Land Survey Monument Record (3) (a) (b) (c) (d) (e) (f) (g) (h) (i). An additional sheet may be added if necessary to conform with said requirements.

(a) Corner location: Township 37 North

Range 9 East

Town/City/Village Pine Lake

County Oneida

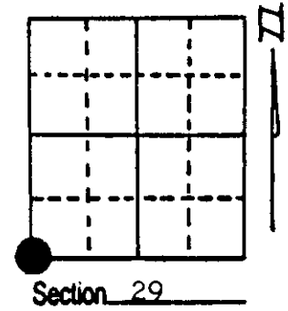

(b) (f) (g) (h) Description of monument found at this corner and if it was accepted, state all evidence (material, testimonial, occupational, plats, records, other monuments) used as a basis for accepting. If not accepted or if nothing was found, state evidence used as basis for establishing location. If reestablished through lost corner proportionate methods, indicate all monuments, distances and directions used to establish.

-1863 Daugherty set Post Aspen 12" S 14 E 25 lks, Aspen 10" N 74 W 16 lks.
-1906 Vaughan set 3' well pipe filled with charcoal 4" under surface and placed a 15" x 18" x 8" rock on top. Hall replaced with official Oneida County Monument brass capped concrete monument stamped to identify corner.
-1988 W. E. Bandow found Hall's monument in place. Referenced as shown below. Survey marker Post set alongside Double R. Pine BT.

(c) (d) (e) Plan view of corner with ties to at least 4 witness monuments. If in disagreement with previously established corner, show the distances between the two corners and also indicate the ties to the disputed corner.

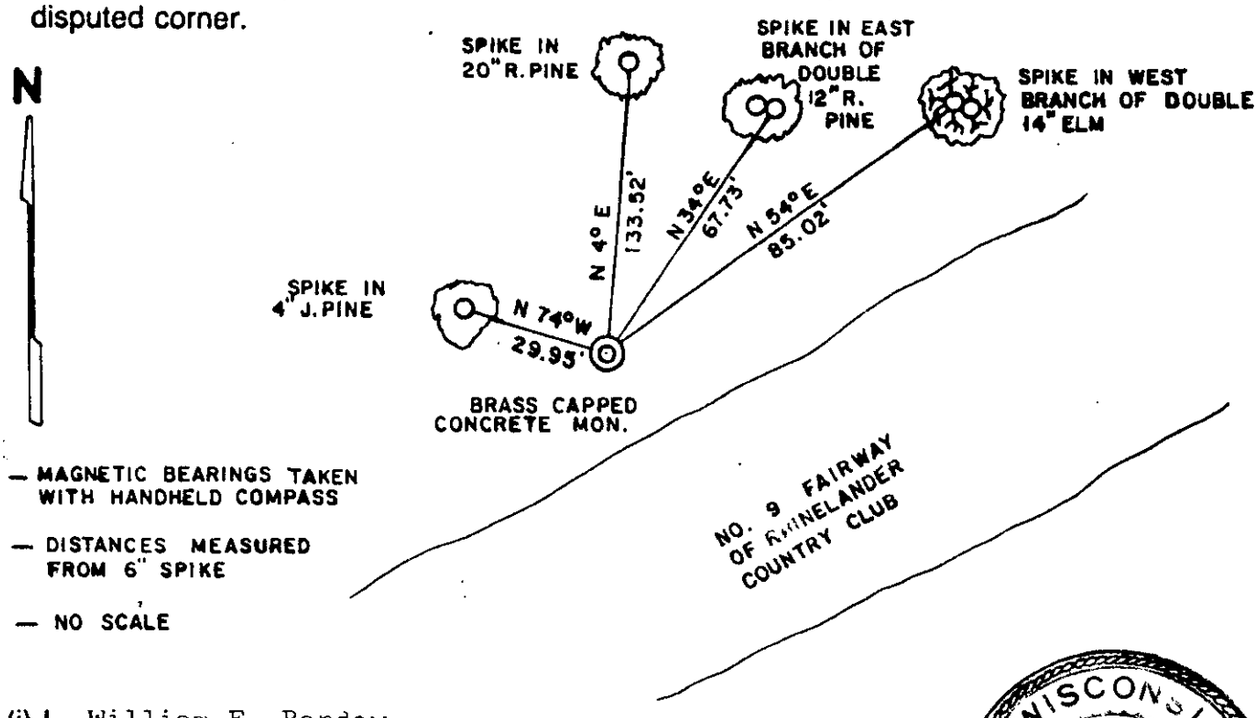

(i) I, William E. Bandow (type or print name) certify that the corner location on this record was determined by me or under my direction and control and that this U.S. Public Land Survey Monument Record is correct and complete to the best of my knowledge and belief.

William E. Bandow 11-2-88

Signature Date

WISCONSIN WILLIAM E. BANDOW S-1182 RHINELANDER WIS. LAND SURVEYOR

Index No. V-5

3709300000