

# U.S. PUBLIC LAND SURVEY MONUMENT RECORD

**Note:** This form is intended and designed to fulfill all requirements of Wisconsin Administrative Code, Chapter A-E 5.02, U.S. Public Land Survey Monument Record (3) (a) (b) (c) (d) (e) (f) (g) (h) (i). An additional sheet may be added if necessary to conform with said requirements.


(a) Corner location: Township 37 North

Range 9 East

City of \_\_\_\_\_

~~Town/Village~~ Rhineland


County Oneida

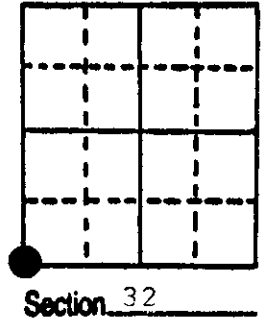

(b) (f) (g) (h) Description of monument found at this corner and if it was accepted, state all evidence (material, testimonial, occupational, plats, records, other monuments) used as a basis for accepting. If not accepted or if nothing was found, state evidence used as basis for establishing location. If reestablished through lost corner proportionate methods, indicate all monuments, distances and directions used to establish.

- 1863 William E. Dougherty West between 5 and 32 80 ch. set post  
Tam. 8" N 36 W 9 lks. Tam 9" S 27 E 17 lks.  
Tam. 8" N 13 E 11 lks. Tam 7" S 24 W 12 lks.
- 1904 Vaughan found original Tam. stumps
- 1956 F.R. Winsentsen found iron pin.
- 1965 F.R. Winsentsen replaced iron pin with 2" capped iron pipe.
- 1987 M.J. Romportl found 2" capped iron pipe
- 1990 William E. Badow found 2" capped iron pipe and witnessed  
as shown below: White Post alongside.

(c) (d) (e) Plan view of corner with ties to at least 4 witness monuments. If in disagreement with previously established corner, show the distances between the two corners and also indicate the ties to the disputed corner.

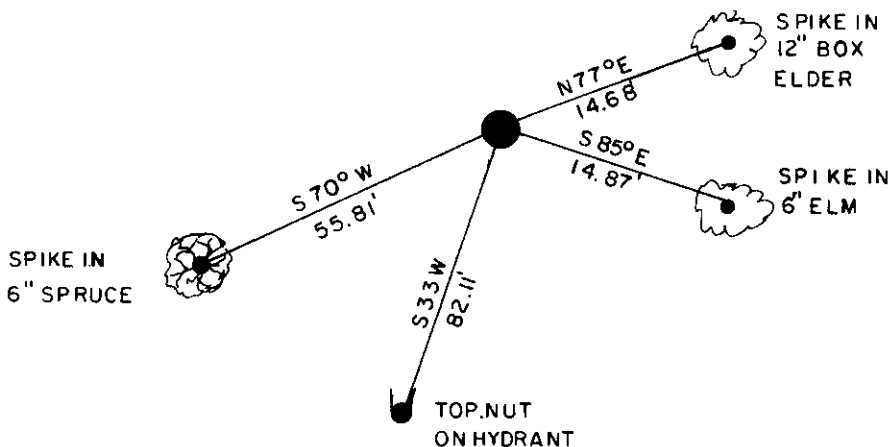

- Magnetic Bearings Taken With Handheld Compass
- Distance to 6" Nail in Side of tree
- No Scale



REGISTER OF DEEDS OFFICE  
ONEIDA COUNTY, WIS.

FILED

DEC 1 1991

At \_\_\_\_\_ O'Clock \_\_\_\_\_ M  
**THOMAS H. LEIGHTON**  
REGISTER OF DEEDS

(i) I, William E. Badow  
(type or print name) certify that the corner location on this record was determined by me or under my direction and control and that this U.S. Public Land Survey Monument Record is correct and complete to the best of my knowledge and belief.

William E. Badow 12-10-91  
Signature Date

GENISOT & ASSOCIATES INC.  
1512 EAGLE ST., RHINELANDER, WIS.



Index No. 2-5

3709310000