

CERTIFIED LAND CORNER RESTORATION



Index No. **X-13**

State of Wisconsin

County of Oneida } ss.

I Phillip T. Hansen, do hereby certify that on the 16th day of February, 1977, I found evidence of the Quarter corner of Section 33-34 Township 37 North, Range 9 East, Fourth Principal Meridian, as described hereon; and that from this evidence I established a new monument and accessories as described hereon to perpetuate the original location of this corner.

Resident witnesses:
Jim Claflin
Herb Wagoner

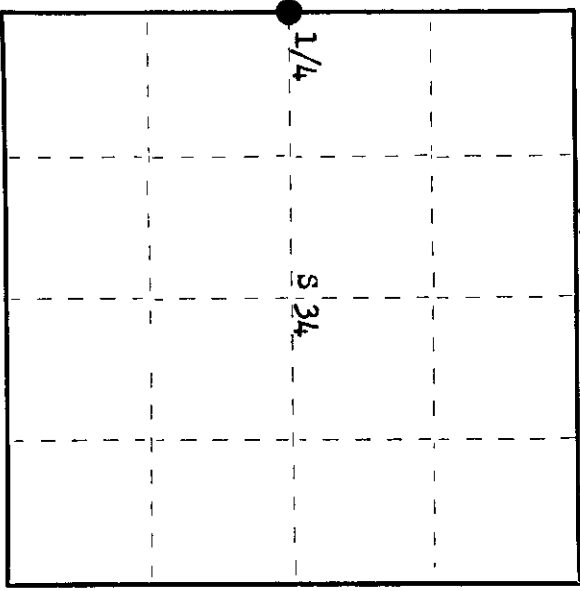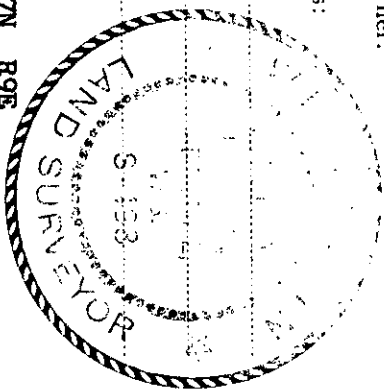

○ = Corner monument restored.

History of original corner establishment:

Original Corner established by Wm. E. Dougherty, Deputy Surveyor, in 1863 from which Maple 6" bears S 54° W 7 links and Yellow Pine 8" bears S 65° E 41 links. Corner recovered by N. Loftus, Ripco Surveyor, in 1961. Found a corner to tie into when he ran the E-W 1/4 line west from E 1/4 corner. No mention made of corner recovered or BTs found. Set 1 1/2" iron pipe.

Description of corner evidence found: Recovered 1 1/2" iron pipe with alloy cap, stamped: Monument projects 30" above ground. Recovered in excellent condition.

Recovered OBTs - Red Pine 20" due East 6.2 links, scribed 1/4 BT.

Red Pine 20" N 50° W 10.0 links, scribed 1/4 BT.

Origin of BTs unknown. T37N R9E 1/4

Recovered an old 6" square cedar along side of iron pipe. S33 + S34

Cedar scribed 1/4 S33, 1/4 S34 W. believed to have been set by RIFCO

V.M. Maine, County Surveyor.

Description of monument and accessories I established to perpetuate the original location of this corner.

As monument was recovered in excellent condition, it was left in place.

NBT - Black Spruce 8" S 68° W 49.8 links, scribed 1/4 BT.

Dated at Rhineland, Wis., this 16th day of March, 1977.

Signature Phillip T. Hansen Title Registered Land Surveyor Registration No. S-498
(County Surveyor, Registered Land Surveyor, or other duly authorized official)

Office of Registrar of Deeds, County of Oneida. I hereby certify that the within instrument was filed in this office for record on the 23rd day of March, 1977 at 3:00 o'clock P. M.

Terrie Nease Kishin
(Registrar of Deeds)

By _____ Deputy

3709332000