

CERTIFIED LAND CORNER RESTORATION

Index No. X-11



State of Wisconsin

County of Oneida } ss.

I Phillip T. Hansen, do hereby certify that on the 22nd day of July, 1977, I found evidence of the C 1/4 corner of Section 33 Township 37, North, Range 9 East, Fourth Principal Meridian, as described hereon; and that from this evidence I established a new monument and accessories as described hereon to perpetuate the original location of this corner.

Resident witnesses:

Jim Claffin
Herb Wagoner

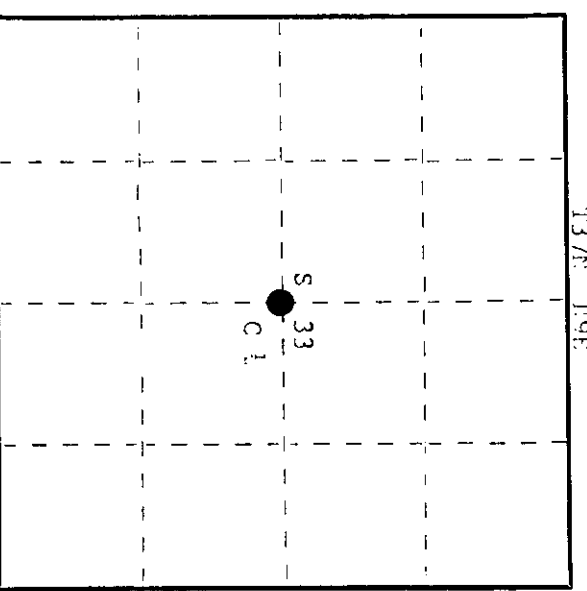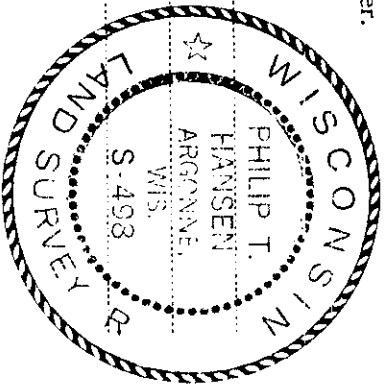

○ = Corner monument restored.

History of original corner establishment:

This corner recovered by Genisot Associates in 1974 while subdividing the SW 1/4. Found old squared post. Did not remonument.

Description of corner evidence found:

Recovered old 2" square spruce post of unknown origin in fair condition, scribed 1 - 1. While digging the hole to set new monument, recovered the points of two old posts. Recovered ORP - Black spruce 5" N90°E, 37.5 links, scribed RT 1/2.

Description of monument and accessories I established to perpetuate the original location of this corner.

Replaced old wood post with 2" Berntsen A-1 Federal Monument, aluminum with magnet in cap and base. Car stamped:
Monument projects 20" above ground.
NRTs - Black spruce 4" S75°E, 64.1 links, scribed 1/4 RT.
Black spruce 4" N36°W, 58.0 links, scribed 1/4 RT.

S408
T37N R9E
C 1 S 33
1977

Dated at Rhineland, Wis., this 29th day of July, 1977

Signature Phillip T. Hansen Title Registered Land Surveyor Registration No. S-498
(County Surveyor, Registered Land Surveyor, or other duly authorized official)

Office of Register of Deeds, County of Oneida
Instrument was filed in this office for record on the 13th day of September, 1977
at 11:00 o'clock A.M.

Herb Wagoner
(Register of Deeds)

By: _____ Deputy

3709332020