

CERTIFIED LAND CORNER RESTORATION

Index No. **X-17**

State of Wisconsin } ss.  
County of Oneida



I Phillip T. Hansen, do hereby  
certify that on the 17th day  
of February, 1977, I found  
evidence of the Quarter  
corner of the Section 34 & 35  
Township 37, North, Range  
9 East, Fourth Principal Meridian,

as described hereon; and that from this evidence  
I established a new monument and accessories  
as described hereon to perpetuate the original  
location of this corner.

Resident witnesses:

Jim Claflin

Herb Wagoner

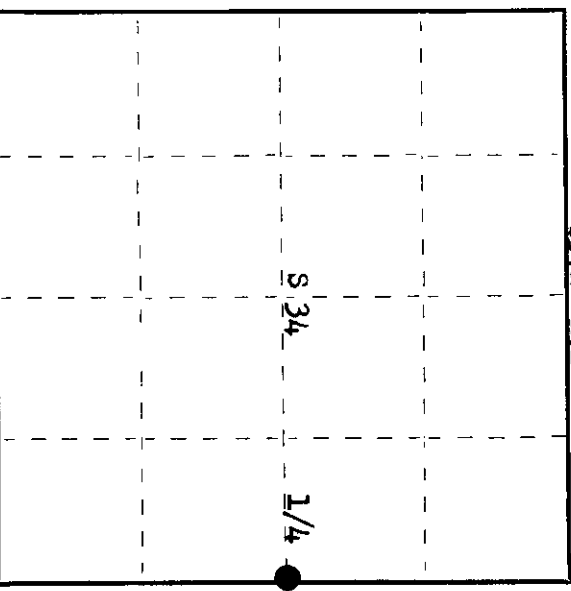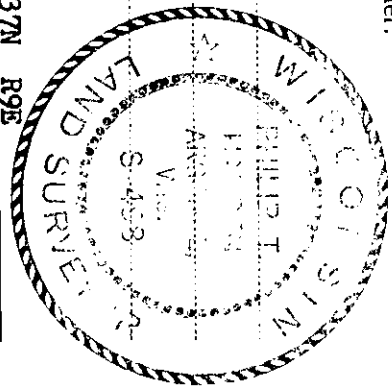

○ = Corner monument restored.

History of original corner establishment: Original Corner established by Wm. E. Dougherty, Deputy Surveyor, in 1863, from which Birch 8" bears N 37° W 18 links and White Pine 10" bears S 49° E 13 links.  
Corner recovered by N. Loftus, Ripco Surveyor, in 1961. Ran random line west bearing 267° 46' mag. 20.186 chains to close out 14 links south of WC 1/16 corner corrected bearing 268° 09' - 50 and ran on new bearing 20.186 chains to close out at a rotted stake and stump BT. Set new post and marked NBT - Oak 5" S 10° W 18-3/4 links and Maple 4" N 55° W 15 1/2 links. Corrected bearing S 88° 09' 50" W.

Description of corner evidence found:

Recovered 1 1/2" iron pipe with alloy cap, stamped:  
Monument projects 24" above ground, in excellent condition. T37N R9E  
Recovered OBTs - Oak 6" S 10° W (S 12° W) 18-3/4 links (19.0 links). 1/4 S34 S35  
Maple 4" (6") N 55° W 15 1/2 links (15.9 links). RIPCO

Description of monument and accessories I established to perpetuate the original location of this corner.  
As monument was recovered in excellent condition, it was left in place.  
Marked NBT - Maple 6" N 20° E 37.7 links, scribed 1/4 BT.

Dated at Rhineland, Wis. this 18th day of March, 1977.

Signature Phillip T. Hansen Title Registered Land Surveyor Registration No. S-498  
(County Surveyor, Registered Land Surveyor, or other duly authorized official)

Office of Register of Deeds, County of Oneida, I hereby certify that the within  
instrument was filed in this office for record on the 14th day of April, 1977  
at 10:30 o'clock A. M.

George W. Kuehn  
(Register of Deeds)

By: \_\_\_\_\_ Deputy

3709 342000