

CERTIFIED LAND CORNER RESTORATION

Index No. X-16

State of Wisconsin

County of Oneida } ss.

I Phillip T. Hansen, do hereby

certify that on the 17th day

of February, 1977, I found

evidence of the EC 1/16

corner of Section 34

Township 37, North, Range

9 East, Fourth Principal Meridian,


as described hereon; and that from this evidence

I established a new monument and accessories

as described hereon to perpetuate the original

location of this corner.


T37N R9E

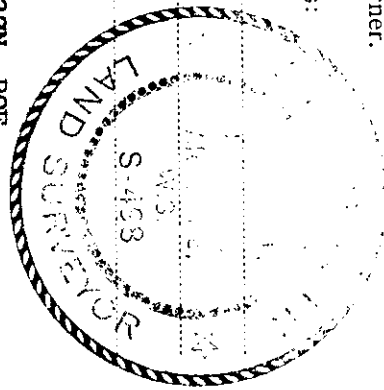

Resident witnesses:

Jim Claflin

Herb Wagoner

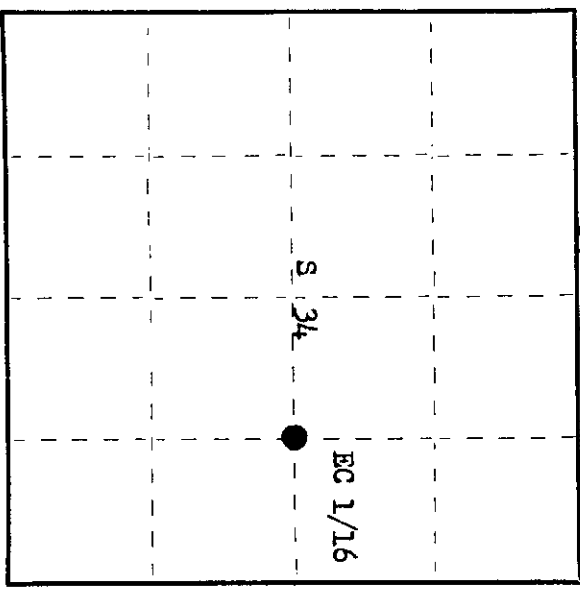

○ = Corner monument restored.

History of original corner establishment:

Corner established by N. Loftus, Ripco Surveyor, in 1961. Ran random line west 261° 02' 03" mag. from E 1/4 corner 87.184 chains to close out 1.413 chains south of W 1/4 corner. Corrected bearing S 81° 58' 13" W, corrected distance to C 1/4 corner 42.346 chains. Set EC 1/16 at 21.173 chains and .3425 chains North. Set iron post and marked Tamarack 1/4" N 12° E 17 1/4 links and Spruce 7" N 40° W 7 1/2 links.

Description of corner evidence found:

Unable to locate any trace of Ripco's corner.
Recovered OBT - Tamarack 4" N 12° E. 17.25 links, scribed CE 1/16 BT, now dead.
Black Spruce 7" N 40° W 75 links, scribed CE 34 BT.
Determined location of corner from cross-ties from BTs.

Description of monument and accessories I established to perpetuate the original location of this corner.

Set a 1 1/2" iron pipe with 2" brass cap for corner. Cap stamped:
Monument projects 20" above ground.
NBT - Red Pine 18" N 66° W 61.8 links, scribed BT.

T37N R9E
EC 1/16 S 34
S498-1977

Dated at Rhineland, Wis. this 18th day of March, 1977.

Signature Phillip T. Hansen Title Registered Land Surveyor Registration No. S-498
(County Surveyor, Registered Land Surveyor, or other duly authorized official)

Office of Registrar of Deeds, County of Oneida
I hereby certify that the within instrument was filed in this office for record on the 23rd day of March, 1977 at 3:00 o'clock P. M.

Dorcas Waage Kuehn
(Registrar of Deeds)

By: _____ Deputy

3709 34 2010