

CERTIFIED LAND CORNER RESTORATION

Index No. W-15


State of Wisconsin

County of Oneida } ss.

I Phillip T. Hansen, do hereby certify that on the 15th day of February, 1977, I found evidence of the NC 1/16 corner of Section 34 Township 37 North, Range 9 East, Fourth Principal Meridian,

as described hereon; and that from this evidence I established a new monument and accessories as described hereon to perpetuate the original location of this corner.

Resident witnesses:
Jim Claflin
Herb Wagoner

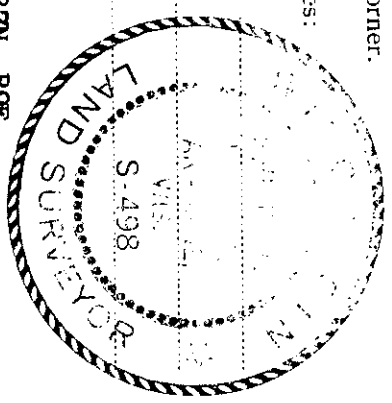


History of original corner establishment:
Corner established by N. Loftus, Ripco Surveyor, in 1961. Ran random line south, bearing 175° 30' from N 1/4 corner a distance of 86.977 chains to close out 3.65 chains west of S 1/4 corner (includes offsets). Ran random line west from east 1/4 corner Sec. 34 & 35, 87.192 chains. Established C 1/4 corner at point 50.153 chains south of N 1/4 corner. Established NC 1/16 at 25.076 chains on true line.
Marked BTs - White Pine 6" S 70° W 18 1/2 links and White Pine 10" S 3° E 22 1/2 links.

Description of corner evidence found:

Recovered 1" iron pipe with alloy cap in good condition. Also a 5" square cedar post scribed CN 1/16 - S34 beside it.
Monument projects 24" above ground. Cap stamped:
Recovered OBTs - White Pine 5" (8") S80°W (S85°W) 18.5 links, scribed CN 1/16 S34
White Pine 10" (12") S 3° E 22.25 links (23.0 links).
N 1/16 C S34

Description of monument and accessories I established to perpetuate the original location of this corner.
As monument was recovered in good condition, it was left in place.
Added T37N R9E to stamping on cap.

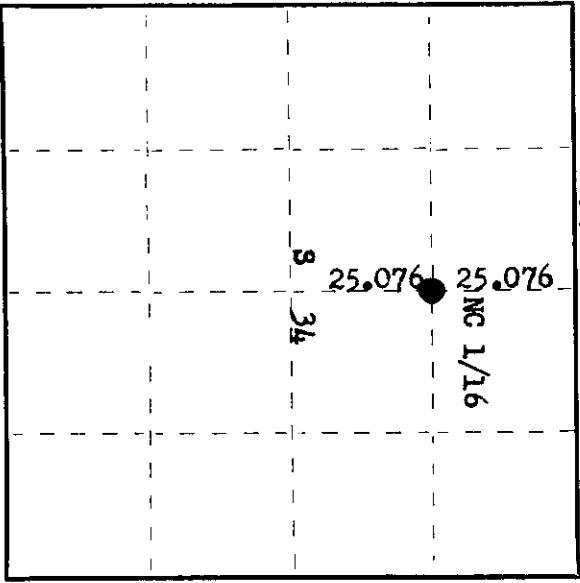

○ = Corner monument restored.

Dated at Rhineland, Wis., this 17th day of March, 1977

Signature Phillip T. Hansen Title Registered Land Surveyor Registration No. S-498
(County Surveyor, Registered Land Surveyor, or other duly authorized official)

Office of Register of Deeds, County of Oneida
Instrument was filed in this office for record on the 23rd day of March, 1977
at 3:00 o'clock P. M.

Dorcas Wagoner Kurland
(Register of Deeds)

By: _____ Deputy

3709343020