

This form is intended to fulfill the requirements of Chapter A-E 7.08 (3)(a) thru (i) U.S. Public Land Survey Monument Location Record, Wisconsin Administrative Code. Use the reverse side of form for continuation.

Recorders Data

U.S. PUBLIC LAND SURVEY MONUMENT LOCATION RECORD

USPLS CORNER: SOUTH WITNESS MC SECTION: 31 TOWNSHIP: 37 NORTH RANGE: 10 EAST
 NAME OF WATERWAY FOR M.C. CORNER: THIRD LAKE SECTION LINE: WEST
 (CITY)(VILLAGE)(TOWN) OF: STELLA COUNTY OF: ONEIDA

Description of monument found or placed and all other evidence used as the basis for monument location; including monuments and related measurements required if the corner location was reestablished by lost corner proportionate methods. Also indicate name of original surveyor, original survey date and the corner monument, bearing trees, witness or other reference monuments established; including measured bearing and distance ties, from available records.

Found and accepted a plumb and secure 1.25" dia. old and rusting iron pipe with uncapped top 4" above bog surface and a 1/2"x2.5"x16" high yellow poly marker stake 6" South of iron pipe. I left pipe in place and drove a standard 2" dia.x 30" long aluminum pipe monument with split bottom end and stamped Oneida County cap over the old pipe to 5" above bog. An old fenceline and flagged previous survey line lead South of corner, which also falls about 18' South of existing lake shoreline this date. Corner is at SE corner of improved lake frontage parcel at Fire No. 3744 Limberlost Road.


In July 1859, Hiram C. Fellows/GLO set a wood post as the original meander corner and marked OBTs: a 7" Pw S20°E 30 links and a 9" Pw S40°W 20 links; all of which are now obliterated, as the MC post was set 43'+/- South of West 1/4 corner in lake, which would place the post and BTs in lake bed this date.

In 1976, Harold W. Behm/RLS 1221 notes a 1.5" dia. iron pipe found at this corner per Plat of Survey C-315 in Oneida County survey records; a very extensive sectional subdivision survey, which notes that this corner is S02°10'34"E 126.88' from the West 1/4 corner of Section 31 which falls in Third Lake.

Upon consultation with and the approval of Oneida County Surveyor Michael Romportl at his office, no further research of records was considered essential to further authenticate this corner recovery.

This corner recovery completed September 12, 2001 and witnessed by adjacent resident G. Dorothy Bronson at Fire No. 3744 Limberlost Road.

Plan view map of monument location with bearing and distance ties to a minimum of four(4) described witness or reference monuments of concrete, natural stone, iron, live bearing trees or equivalent material. If applicable, also show a minimum of two(2) bearing and distance ties to any other monument found and not accepted; including the bearing and distance from the accepted monument.

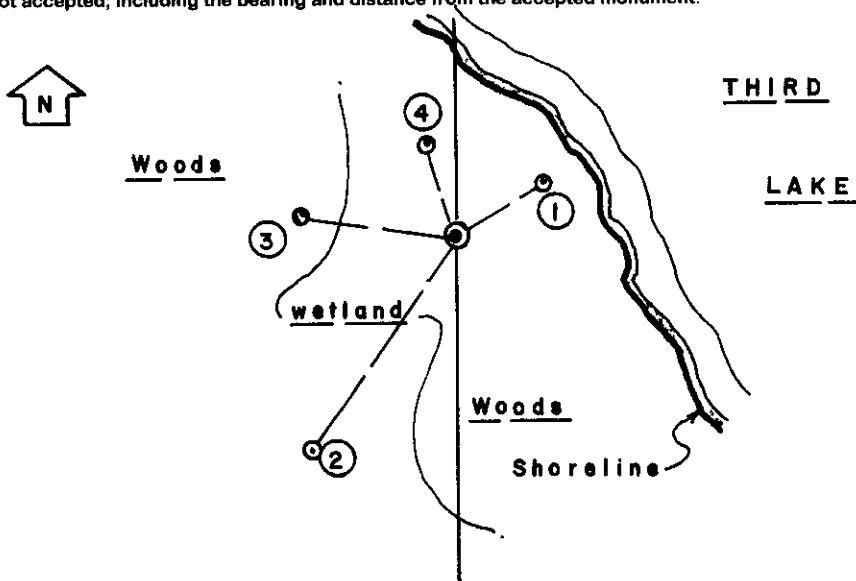

WITNESS MONUMENT TIES:

- ① New BT 7.5" Sb N32°E 10.75'.
- ② New BT 9" Sb S34°W 27.20'.
- ③ New BT 9.5" Sb N81°W 16.15'.
- ④ New BT 7" Sb N15°W 9.98'.

Standard white poly 'T' corner marker post set 7" East of corner monument.

No older BTs observed nearby.

SCALE: 1" = 20'

Unless otherwise indicated, all bearing tree ties are to a .25" dia. by 2.5" long PK nail with a 1.25" dia. steel washer driven into unblazed right face and a .25" dia. by 2.5" long PK nail with a 2" dia. steel washer stamped BT is also driven into unblazed face of bearing tree at DBH; the basis for measured bearings is by compass to nearest degree and all tie distances are measured horizontal by steel tape corrected to nearest 1/100th feet at standard temperature of 68° F.

RLS SEAL:




LAND SURVEYOR CERTIFICATE:

I, William C. Rohde, hereby certify that I am duly licensed as a Professional Land Surveyor in the State of Wisconsin; that this USPLS monument location was determined by me and/or under my direct supervision and control; and that this U.S. Public Land Survey Monument Location Record is true and correct to the best of my knowledge and belief.

Signed *William C. Rohde*
 William C. Rohde RLS 841

Date Signed: March 25, 2002

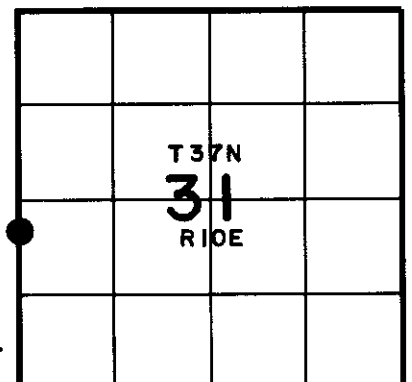

SECTION LOCATION MAP
 INDEX NO. 171

361800