

CERTIFIED LAND CORNER RESTORATION

D-1 Index No. **D-1**

State of Wisconsin

County of Oneida } ss.

I Philip T. Hansen 2nd, do hereby



certify that on the 2nd day of May, 1975, I found

evidence of the S-1/16 corner of between Sections 6 and 1

Township 37 North, Range 11 and 10, Fourth Principal Meridian,

as described hereon; and that from this evidence I established a new monument and accessories as described hereon to perpetuate the original location of this corner.

Resident witnesses:

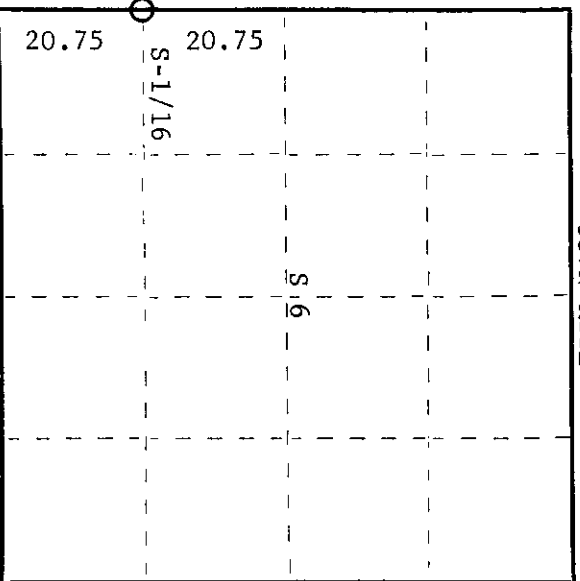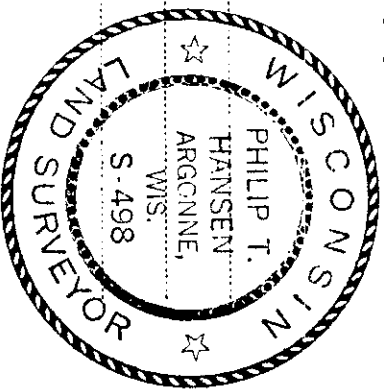

○ = Corner monument restored.

History of original corner establishment:

Original corner established by Hiram C. Fellows, Govt. Deputy Surveyor in 1859, from which tamarack 5" bears N89W, 23 links, and spruce 7" bears N530E, 24 links.

Corner recovered by H.C. Lawrence when he made retracement survey in 1960. He ran south 20°East (mag.) from 1/4 corner between Sections 1 and 6 at 20.76 chains found an S-1/16 corner post at foot of steep slope, south of the road. This corner probably established by V.M. Maine.

Description of corner evidence found:

Recovered 4" cedar post, squared and scribed 1/8SM 1/8SM in poor condition but still standing.

Description of monument and accessories I established to perpetuate the original location of this corner.

Replaced wooden post with 1-1/2" iron pipe w/2" brass cap stamped -

Established NBT's: Cedar 10" S80W 46.2 links scribed 1/16 BT R S498
 Hemlock 12" S740W 78.2 links scribed 1/16 BT E T37N

R S1 S6 R
 E S-1/16 E
 CPT-1975

Dated at Rhinelander Wis., this 25th day of June, 1975.

Signature *Philip T. Hansen* Title Registered Land Surveyor Registration No. S-498
 County Surveyor, Registered Land Surveyor, or other duly authorized official

Office of Register of Deeds, County of Oneida
 Instrument was filed in this office for record on the 1st day of October, 1975
 at 3:00 o'clock P.M.

Doris Lange Fisher
 (Register of Deeds)

By: Deputy

000100171