

CERTIFIED LAND CORNER RESTORATION



Index No. **C-1**

State of Wisconsin }  
 County of Oneida } ss.

I Phillip T. Hansen, do hereby certify that on the 8th day of September 19 76, I found evidence of the Quarter corner of Sections 1 and 6 Township 37, North, Range 10 & 11 East, Fourth Principal Meridian, as described hereon; and that from this evidence I established a new monument and accessories as described hereon to perpetuate the original location of this corner.

Resident witnesses:

- Glen Barker
- Jim Claffin
- Herb Wagoner

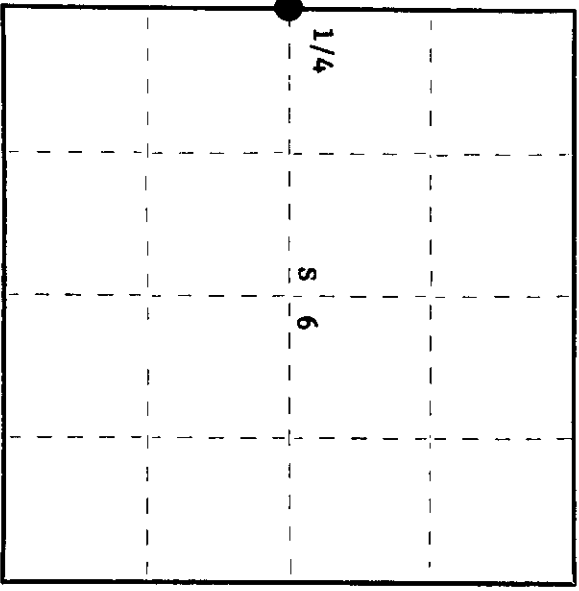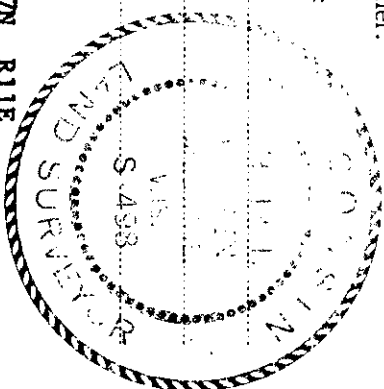

○ = Corner monument restored.

History of original corner establishment: Original Corner established by Wm. E. Dougherty, Deputy Surveyor, in 1859, from which tamarack 5" bears N 80° W, 23 links and Spruce 7" bears N 53° E, 24 links.  
 Corner recovered by D.H. Vaughan, County Surveyor, in 1909. Set new post and placed stake in rotten stump of OBT - Tamarack N 80° W, 23 links. Set NBT - Y.Pine N 63° E 203 1/2 links.  
 Corner recovered by H.C. Lawrence, Registered Land Surveyor, in 1958. Found Vaughan's old post and a 1" iron pipe. Recovered Vaughan's OBT - Y.Pine N 63° E 203 1/2 links.  
 Lawrence set new post and marked NBT - Y.Pine 8" N 64° E, 214 links.

Description of corner evidence found:

Recovered Vaughan's old cedar post, top half rotted off, also H.C. Lawrence's 6" cedar post, squared and scribed 1/4S S1, 1/4S S6, setting 1 link north of Vaughan's post. Also recovered 1" iron pipe beside Vaughan's post.  
 Recovered old cedar stake that was placed in original tamarack BT N 80° W 23 links.  
 Recovered Vaughan's OBT - Y.Pine (stump) N 63° E (N 65° E) 203.5 links, scribed BT.  
 Lawrence's OBT - Y.Pine 8" (10") N 64° E 214 links (215 links), scribed 1/4S 6.

Description of monument and accessories I established to perpetuate the original location of this corner.  
 Replaced Vaughan's old post with 2 1/2" Bernitsen A-1 Federal Monument stamped:  
 Monument projects 18" above ground.  
 Drove support stakes in muck around pipe.  
 NBT - Red Pine 20" S 26° E 299.4 links, scribed 1/4 BT.  
 Monument and BT's painted blue.

T37N R  
 1 1/4 6 11  
 E  
 S498-1976

Dated at Rhineland, Wis., this 13th day of September, 19 76

Signature: Phillip T. Hansen Title: Registered Land Surveyor Registration No. S-498  
 (County Surveyor, Registered Land Surveyor, or other duly authorized official)

Office of Register of Deeds, County of Oneida  
 at 9:30 o'clock 6th day of September, 19 76  
M. I hereby certify that the within instrument was filed in this office for record on the

Doree Leauge Kuehn  
 (Register of Deeds)

By: \_\_\_\_\_ Deputy

3710012000