

CERTIFIED LAND CORNER RESTORATION

Index No. **B-1**

State of Wisconsin }


I, Phillip G. Hansen, do hereby certify that on the 8th day of September, 1976, I found evidence of the 1/16 corner of Section 1 and 9 Township 37, North, Range 10 East, Fourth Principal Meridian, as described hereon; and that from this evidence I established a new monument and accessories as described hereon to perpetuate the original location of this corner.

Resident witnesses:

Glen Barker

Jim Clafflin

Herb Anderson

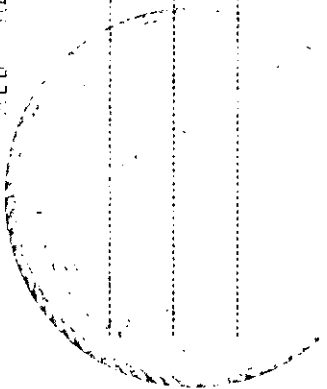


○ = Corner monument restored.

History of original corner establishment:

Corner established by H.C. Lawrence, Registered Land Surveyor, in 1900. Main & center line south & center from section corner, bearing corner 45° 30' 00" S. Original government 1/4 corner is 4.00 chains east, which has been recovered by J.H. Ferguson, County Surveyor, in 1909. Set wood post for 1/16 1.90 chains east at right angles from S.C. 1/4. Marked "Marked 5" x 73° x 39 lks.

Description of corner evidence found:

Recovered Lawrence's 6" cedar post, squared and scribed 1/16 on 1/16 on in fair condition. Recovered 5" x 73° x 39 lks, scribed 1/16 on 1/16 on.

Description of monument and accessories I established to perpetuate the original location of this corner.

Replaced 6" cedar post with 1 1/2" OD iron pipe with 3" brass cap stamped: Monument projects 10" above ground. 5" - Black spruce 5" x 1 1/4" x 35" lks, scribed 1/16 on 1/16 on. Monument and 5" x 73° x 39 lks.

2493
 1372
 10 1/16
 11
 CH-1976


 (County Surveyor, Registered Land Surveyor, or other duly authorized official)

 at 10:35 o'clock A.M. I hereby certify that the within instrument was filed in this office for record on the 9th day of November, 1976.

James George Kuehn
 (Register of Deeds)

By: _____ Deputy

3710013000