U.S. PUBLIC LAND SURVEY MONUMENT RECORD

Note: This form is intended and designed to fulfill all requirements of Wisconsin Administrative Code, Chapter A-E 7.08 U.S Public Land Survey Monument Record (3) (a) (b) (c) (d) (e) (f) (g) (h) (i). An additional sheet may be added if necessary to conform with said requirements.

(a) Corner location: Township 37 North

Range 10 East/West

Town/City/Village Stella

County Oneida

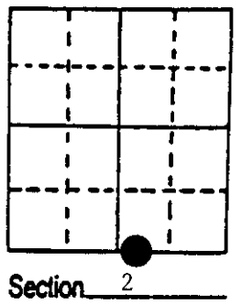

(b) (f) (g) (h) Description of monument found at this corner and if it was accepted, state all evidence (material, testimonial, occupational, plats, records, other monuments) used as a basis for accepting. If not accepted or if nothing was found, state evidence used as basis for establishing location. If reestablished through lost corner proportionate methods, indicate all monuments, distances and directions used to establish. Indicate type of monument found or set and sign post.

1863 - William Daugherty established this corner and set Meander Post and BTs:
8" Spruce, N88°E, 49 Links 10" Birch, S83°E, 54 Links

1932 - Hall called Meander Corner as an iron pipe with BTs:
14" Hemlock, N20°E, 54.1 Links 4" Spruce, S75°E, 8.3 Links

8/2/1989 - Milo E. Stefan found corner marked with a 3" x 24" iron pipe. No evidence of the original corner remains. A recently fallen local BT, 16" Hemlock, bears N20°E, 35.1'. This is a pipe placed by surveyor Hall in the 1930's. It has been recognized as the Meander Corner for many years. I, therefore, accept this iron pipe as the perpetuated corner position and restore it with an aluminum county monument, making new bearing trees and placing a plastic sign post.

(c) (d) (e) Plan view of corner with ties to at least 4 witness monuments. If in disagreement with previously established corner, show the distances between the two corners and also indicate the ties to the disputed corner.

1) 2 1/2" x 30" Aluminum Oneida County Monument
2) 3" Hemlock, N9°E, 33.72'
3) 5" Hemlock, N47°E, 34.81'
4) 5" Red Maple, N89°E, 34.47'
5) 3" Sugar Maple, S33°E, 30.27'
6) Plastic sign post, SE, .8'

Distances to nail in side of BTs.
BTs scribed "BT" in stump blaze.

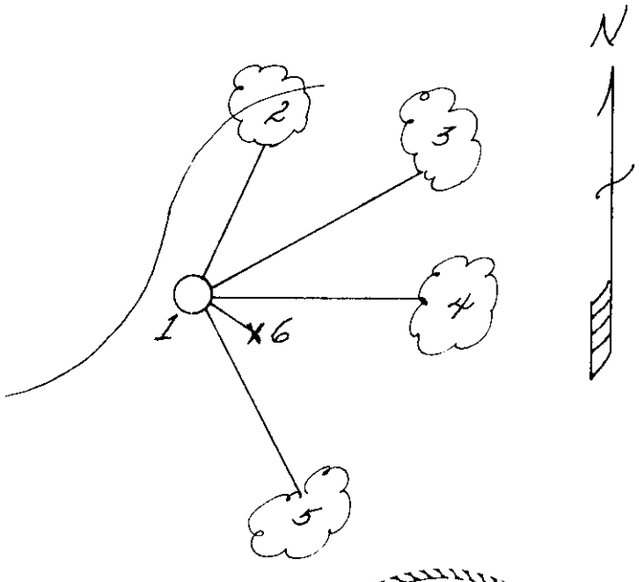

(i) I, Milo E. Stefan

(type or print name) certify that the corner location on this record was determined by me or under my direction and control and that this U.S. Public Land Survey Monument Record is correct and complete to the best of my knowledge and belief.

Milo E Stefan 8/10/89

Signature Date

Index No. E-19, 20

3710020012