

CERTIFIED LAND CORNER RESTORATION

Index No. E-7



State of Wisconsin

County of Oneida } ss.

I, Phillip T. Hansen, do hereby certify that on the 6th day of June, 19 77, I found evidence of the Quarter corner of Section 5 & 8 Township 37, North, Range 10 East, Fourth Principal Meridian, as described hereon; and that from this evidence I established a new monument and accessories as described hereon to perpetuate the original location of this corner.

Resident witnesses:

Jim Claffin  
Herb Wagoner

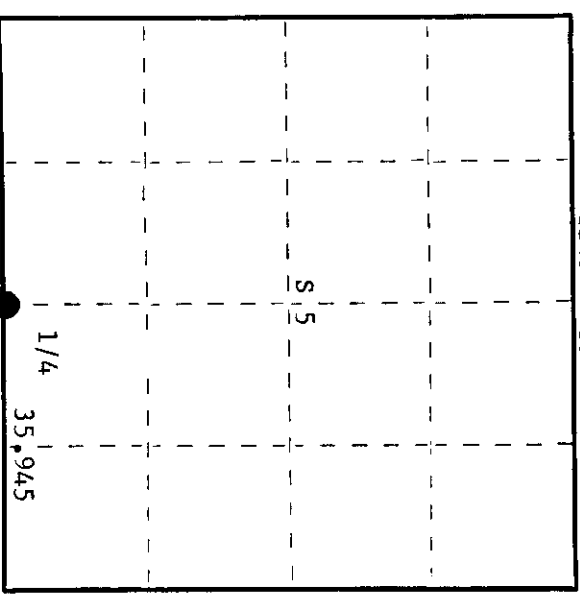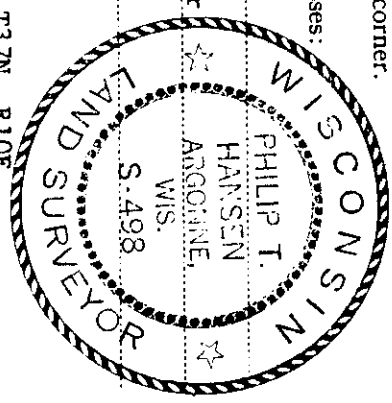

○ = Corner monument restored.

History of original corner establishment:

Corner established by Wm. E. Dougherty, Deputy Surveyor, in 1863, from which Birch 10" bears S36°W, 13 links and White Pine 12" bears N18°E, 12 links. Corner restored by B.F. Dorr, County Surveyor. N. Loftus, Ripco Surveyor, ran random line west from SE corner in 1959 at 35.945 chains, closed out 65 links south of Dorr's 1/4 corner. Set new post.

Description of corner evidence found:

Recovered OBTs - Maple 6" N48°W, 8.2 links and Maple 8" S88°E, 52.4 links. Scribing visible, but not legible.  
Recovered 1-3/4" iron pipe with 4" square brass cap in good condition.  
Monument projects 24" above ground. Cap stamped:

T37N R10E  
S 5  
1/4 S 1/8  
RIPCO

Description of monument and accessories I established to perpetuate the original location of this corner.

Marked NBT - Maple 5" S80°W, 41.7 links, scribed 1/4 BT.

Dated at Rhineland, Wis., this 8th day of June, 19 77

Signature Phillip T. Hansen Title Registered Land Surveyor Registration No. S-498  
(County Surveyor, Registered Land Surveyor, or other duly authorized official)  
Office of Register of Deeds, County of Oneida, I hereby certify that the within instrument was filed in this office for record on the 23rd day of June, 19 77 at 12:40 o'clock M.

Dore Berger  
(Register of Deeds)

By..... Deputy

3710050020