

CERTIFIED LAND CORNER RESTORATION

Index No. B-7

State of Wisconsin

County of Oneida } ss.

I Phillip T. Hansen, do hereby certify that on the 2nd day

of June, 1977, I found evidence of the NC 1/16


corner of Section 5 Township 37, North, Range 10 East, Fourth Principal Meridian,

as described hereon; and that from this evidence I established a new monument and accessories as described hereon to perpetuate the original location of this corner.

Resident witnesses:

Jim Claffin

Herb Wagoner

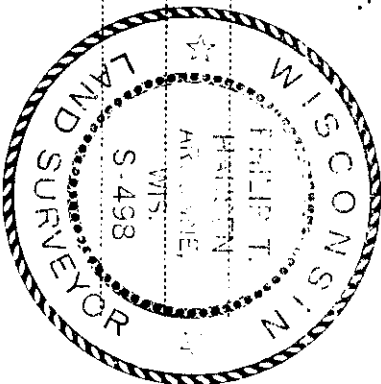

History of original corner establishment:
Corner established by N. Loftus, Ripco Surveyor, in 1959. Ran north, bearing 2° 00' from S 1/4 corner to close out 60 links, west of N 1/4 corner at 79.47 chains. Set NC 1/16 at 61.04 chains, 20.53 chains North 2° 26' E of C 1/4.

Marked NBT - Red Maple 3" N77°W, 19 links and White Pine 4" N18°W, 50 links.


Description of corner evidence found:

Recovered 1" OD iron pipe with 2" square brass cap in good condition and firmly in ground. White Pine 4" S18°W 50 links has been destroyed by field work. Recovered Red Maple 3" N77°W, 19 links. Scribbling not legible. Monument projects 14" above ground. Cap stamped:

T37N C R10E
N 1/16 ~~+~~ S5
C
RIPCO

Description of monument and accessories I established to perpetuate the original location of this corner. As monument was recovered in good condition, it was left as recovered. Marked NBTs - Maple 6" N4°W 38.7 links, scribed 1/16 BT.

T37N R10E

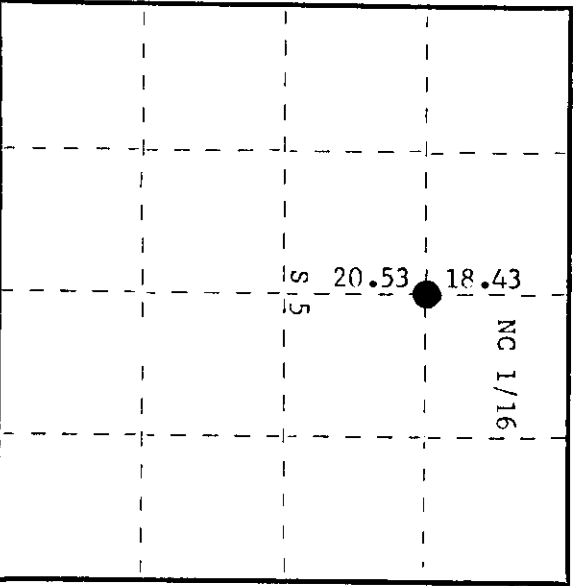

O = Corner monument restored.

Dated at Rhinelander, Wis., this 7th day of June, 1977.

Signature Phillip T. Hansen Title Registered Land Surveyor Registration No. S-498
(County Surveyor, Registered Land Surveyor, or other duly authorized official)

Office of Register of Deeds, County of Oneida, I hereby certify that the within instrument was filed in this office for record on the 23rd day of June, 1977 at 2:40 o'clock P. M.

Dorcas Leverage Fiedler
(Register of Deeds)

By: _____ Deputy

202500103