

CERTIFIED LAND CORNER RESTORATION


Index No. **B-6**

State of Wisconsin

County of Oneida } ss.

I, Phillip T. Hansen, do hereby certify that on the 2nd day of June, 19 77, I found evidence of the NW 1/16 corner of Section 5 Township 37, North, Range 10 East, Fourth Principal Meridian, as described hereon; and that from this evidence I established a new monument and accessories as described hereon to perpetuate the original location of this corner.


Resident witnesses:
Jim Claffin
Herb Wagoner

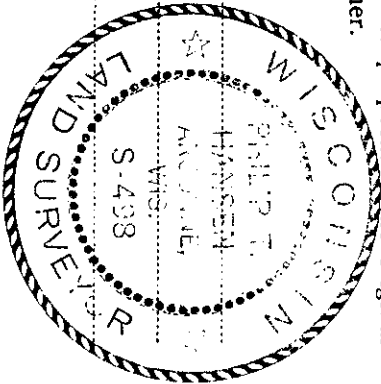

History of original corner establishment:
Corner established by N. Loftus, Ripco Surveyor, in 1959. From established from running 91' 20" from previously established N 1/16 on west line 39.97 chains to close out 2 links south of NW 1/16 corner.
Set NW 1/16 corner at 19.98 1/2 chains, 1 link north.
Marked NBTs - Tamarack 3" N25°W, 47 1/2 links and Black Spruce 3" S17°W, 42 links.

Description of corner evidence found:
Recovered 1" OD iron pipe with 2" square brass cap, stamped:
Recovered OBTs - Black Spruce 3" S17°W, 42 links (dead).
Tamarack 3" N25°W, 47 1/2 links, scribed NW 1/16 BT.
Monument projects 10" above ground.
NW 1/16 + S5
RIPCO

Description of monument and accessories I established to perpetuate the original location of this corner.
Monument left as recovered.
Marked NBTs - Tamarack 6" S86°W, 34.0 links, scribed 1/16 BT.

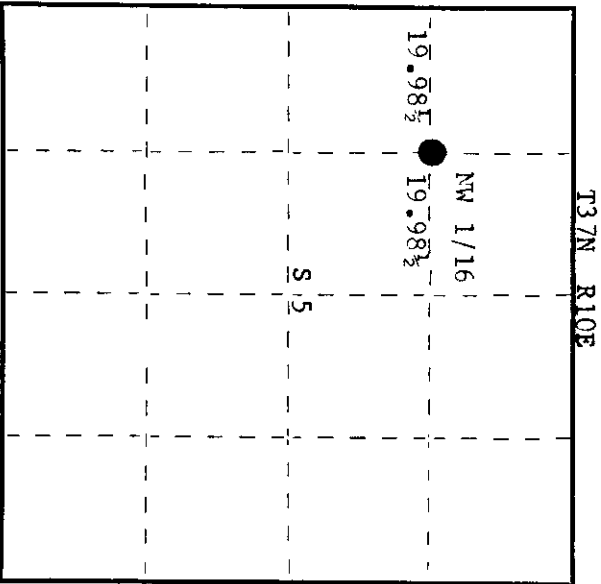

○ = Corner monument restored.

Dated at Rhineland, Wis., this 7th day of June, 19 77.

Signature Phillip T. Hansen Title Registered Land Surveyor Registration No. S-498
County Surveyor, Registered Land Surveyor, or other duly authorized official

Office of Register of Deeds, County of Oneida
at 12:40 o'clock P M. 23rd day of June, 19 77.
I hereby certify that the within

Doris Verage Kuehn
(Register of Deeds)

By Doris Verage Kuehn Deputy

3710053030