



CERTIFIED LAND CORNER RESTORATION

Index No. **G-13**

State of Wisconsin } ss.  
County of Oneida

I Philip T. Hansen, do hereby certify that on the 22nd day of July, 1977, I found evidence of the C 1/4 corner of Section 7 Township 37 North, Range 10 East, Fourth Principal Meridian, as described hereon; and that from this evidence I established a new monument and accessories as described hereon to perpetuate the original location of this corner.

Resident witnesses:  
Jim Clafflin  
Herb Wagoner

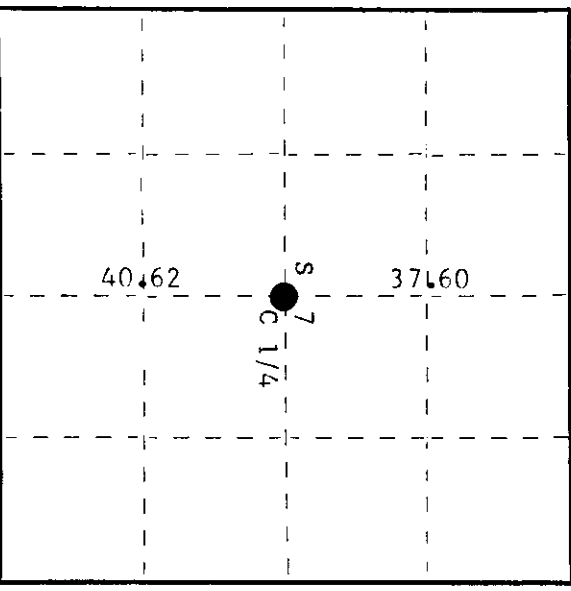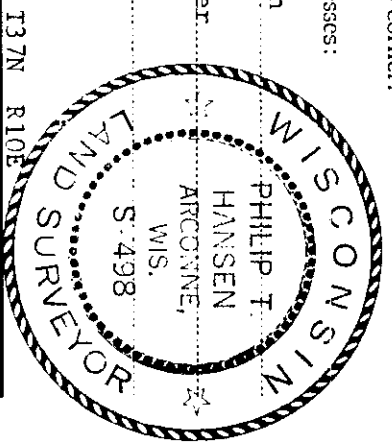

○ = Corner monument restored.

History of original corner establishment:  
Original Corner established by D.H. Vaughan, County Surveyor.

Corner recovered by N. Loftus, Ripco Surveyor, in 1958. Ran random line north from recovered S 1/4 corner at 40.62 chains, intersected Vaughan's C 1/4 and found his BTs. Set iron pipe and NBTs - Black Spruce 5' S84°E, 43 1/2 links  
Red Pine 3' S74°W, 1.37 chains.

Description of corner evidence found:  
Recovered 2" iron pipe with 4" square brass cap, stamped:  
Monument is witness corner for 1 1/2" iron rod in center of cross-country road, which is 25 links east.  
Recovered CRTs - Red Pine 3" (100) S74°W, 1.37 chains (1.363 chains) T37N R10E  
Black Spruce 5" (70) S84°E, 43.5 links (44.5 lks) C 1/4 S7  
Corner 25 lks East  
RIPCO

Description of monument and accessories I established to perpetuate the original location of this corner.  
No additional accessories established.

Dated at Rhinelander, Wis., this 29th day of July, 1977

Signature: *Philip T. Hansen* Title: Registered Land Surveyor Registration No. S-498  
(County Surveyor, Registered Land Surveyor, or other duly authorized official)

Office of Registrar of Deeds, County of Oneida  
Instrument was filed in this office for record on the 5th day of August, 1977  
at 9:00 o'clock A.M.

Signature: *Doris Veragee Kuehn*  
(Registrar of Deeds)

By: \_\_\_\_\_ Deputy

3710072000