U.S. PUBLIC LAND SURVEY MONUMENT RECORD

Note: This form is intended and designed to fulfill all requirements of Wisconsin Administrative Code, Chapter A-E 7.08 U.S. Public Land Survey Monument Record (3) (a) (b) (c) (d) (e) (f) (g) (h) (i). An additional sheet may be added if necessary to conform with said requirements.

(a) Corner location: Township 37 North

Range 10 East/West

Town/City/Village Stella

County Oneida

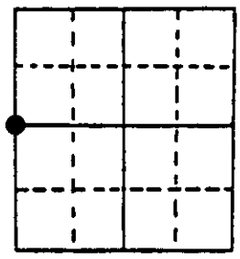

Section 11

(b) (f) (g) (h) Description of monument found at this corner and if it was accepted, state all evidence (material, testimonial, occupational, plats, records, other monuments) used as a basis for accepting. If not accepted or if nothing was found, state evidence used as basis for establishing location. If reestablished through lost corner proportionate methods, indicate all monuments, distances and directions used to establish. Indicate type of monument found or set and sign post.

1863 - Wm. Daugherty 40.00 set wood post.
B.T.'s Aspen 10" N 36° W 10lks
Birch 12" S 24° E 25lks

1930 - H.C. Hall does not show W 1/4 of Section 11 in place during survey for Stella Town Roads. Hall finds NW Sec. corner and SW Sec. corner and remonuments. Map C879 (Hall) shows Sec line running down center of road and gives a distance between the NW Sec. corner and the SW Sec. corner as 5569.7 feet.

1999 - Farming in the area has obliterated any original evidence. Corner was reestablished using single proportion method. Set R.R. Spike in pavement.

(c) (d) (e) Plan view of corner with ties to at least 4 witness monuments. If in disagreement with previously established corner, show the distances between the two corners and also indicate the ties to the disputed corner.

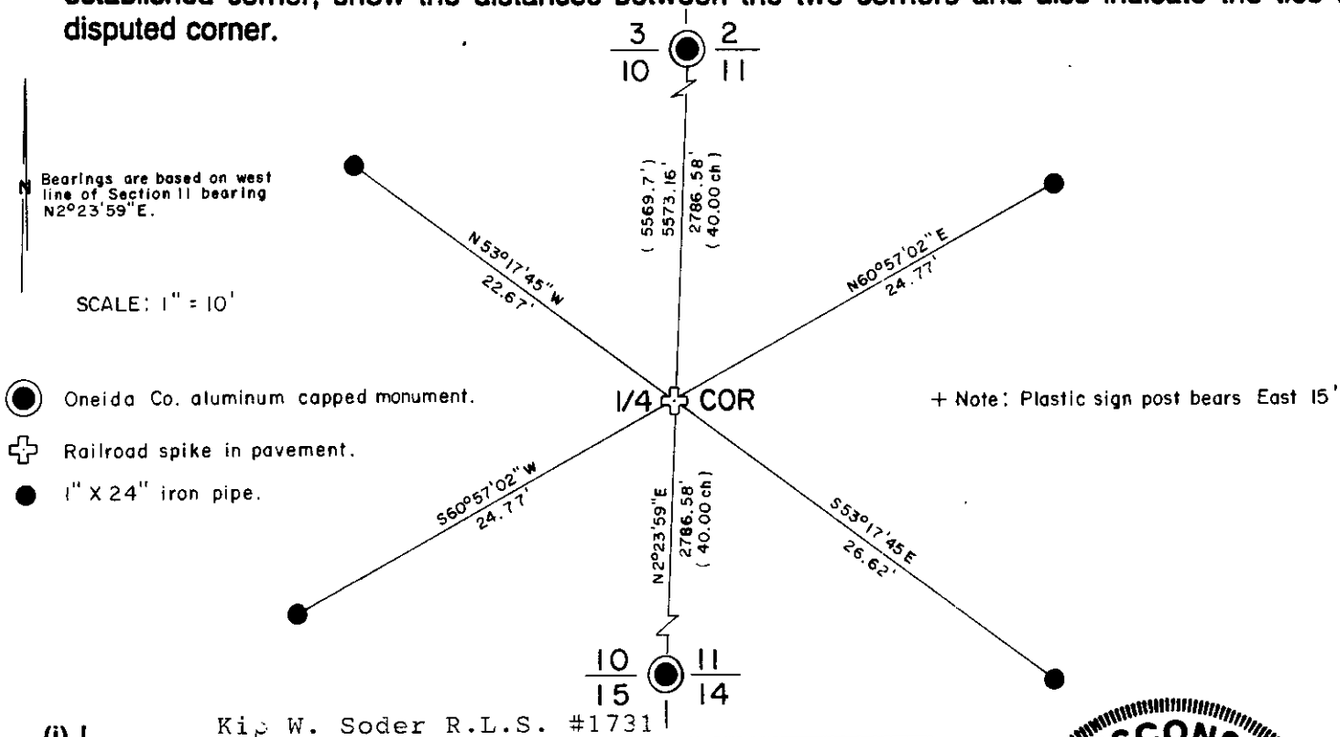

(i) I, Kip W. Soder R.L.S. #1731 (type or print name) certify that the corner location on this record was determined by me or under my direction and control and that this U.S. Public Land Survey Monument Record is correct and complete to the best of my knowledge and belief.

Kip W. Soder 5/20/99

Signature Date

WISCONSIN KIP W. SODER S-1731 THREE LAKES, WI LAND SURVEYOR

Stamp

Index No. G-11, 37-10-7 E C