U.S. PUBLIC LAND SURVEY MONUMENT RECORD

Note: This form is intended and designed to fulfill all requirements of Wisconsin Administrative Code, Chapter A-E 7.08 U.S. Public Land Survey Monument Record (3) (a) (b) (c) (d) (e) (f) (g) (h) (i). An additional sheet may be added if necessary to conform with said requirements.

(a) Corner location: Township 37 North

Range 10 East ~~West~~

Town/~~City~~/Village Stella

County Oneida

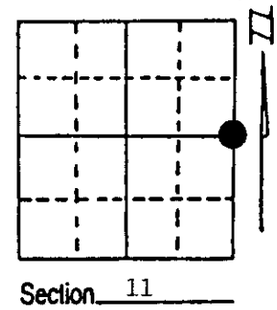

Section 11

(b) (f) (g) (h) Description of monument found at this corner and if it was accepted, state all evidence (material, testimonial, occupational, plats, records, other monuments) used as a basis for accepting. If not accepted or if nothing was found, state evidence used as basis for establishing location. If reestablished through lost corner proportionate methods, indicate all monuments, distances and directions used to establish. Indicate type of monument found or set and sign post.

1863 - William Daugherty established this corner and set a wood post/BTs:
9" Sugar, N73°E, 9 Links
10" Birch, N31°W, 10 Links

1959 - BLM - (GLO)
Set brass capped iron pipe monument with BTs:
8" White Birch, N45°E, 3.30'
6" Black Cherry, S20°W, 8.40'

8/2/89 - Milo E. Stefan found GLO brass cap with both BTs dead snags. We made new BTs and set plastic sign post.

(c) (d) (e) Plan view of corner with ties to at least 4 witness monuments. If in disagreement with previously established corner, show the distances between the two corners and also indicate the ties to the disputed corner.

1) 2 1/2" x 30" GLO brass capped iron pipe monument
2) 8" White Birch snag, N45°E, 3.30'
3) 6" Black Cherry, S20°W, 8.40'
4) 5" Sugar Maple, N66°E, 29.36'
5) 12" Red Maple, S40°E, 8.73'
6) 8" Black Ash, S60°W, 20.63'
7) 6" Black Ash, N77°W, 30.13'
8) Plastic sign post, SE, .8'

Distances to nail in side of BTs.
BTs scribed "BT" in stump blaz.

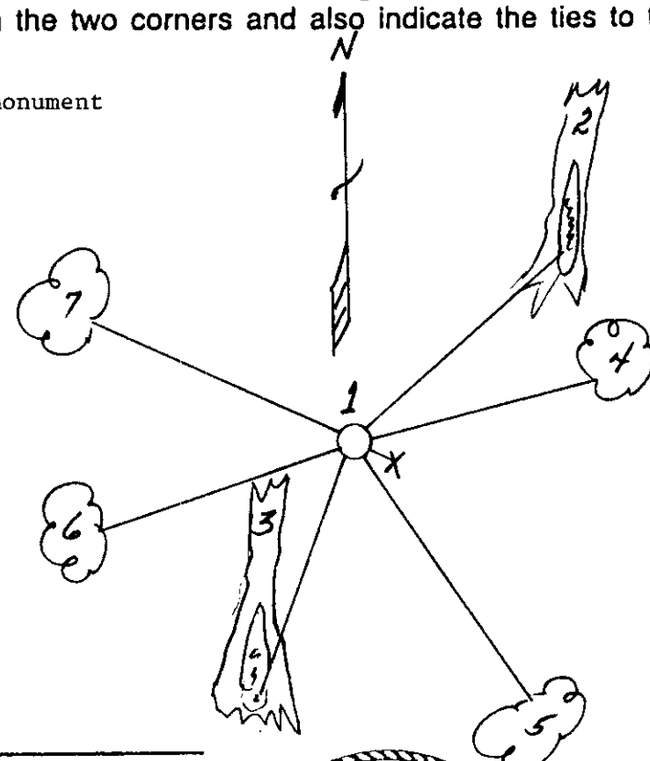

(i) I, Milo E. Stefan (type or print name) certify that the corner location on this record was determined by me or under my direction and control and that this U.S. Public Land Survey Monument Record is correct and complete to the best of my knowledge and belief.

Milo E Stefan — 8/5/89

Signature — Date

WISCONSIN
MILO E. STEFAN
S-1558
RHINELANDER, WIS.
LAND SURVEYOR

Index No. G-21

3710112000