

CERTIFIED LAND CORNER RESTORATION

Index No. **J-1**

State of Wisconsin

County of Oneida } ss.



I, Philip T. Hanson, do hereby certify that on the 15th day of September, 1976, I found evidence of the section corner of sec. 7-12-13-18 Township 37 North, Range 10 East, Fourth Principal Meridian, as described hereon; and that from this evidence I established a new monument and accessories as described hereon to perpetuate the original location of this corner.

Resident witnesses:

Alan Parker

Jim Staffin

Herb Peterson

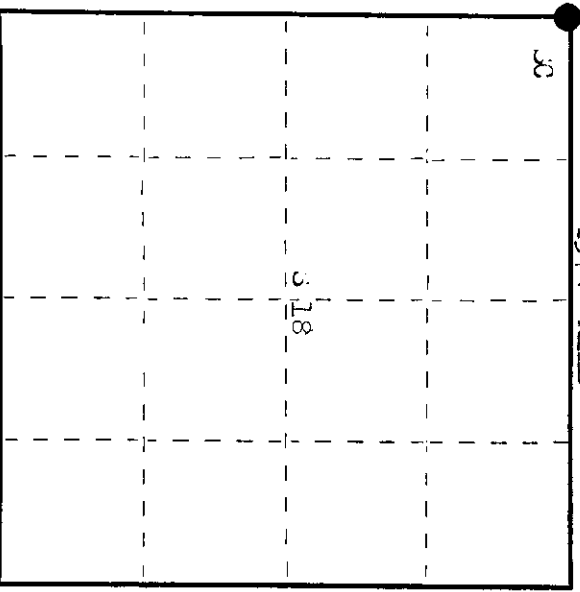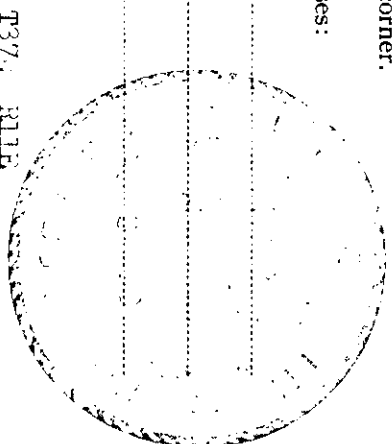

○ = Corner monument restored.

History of original corner establishment:

Original corner established by Henry J. Jellons, Deputy Surveyor, in 1855, from which there is a 7 link, 10" x 4" x 4" line, hemlock 10" x 4" x 4" line and a 10" x 4" x 4" line. Corner restored by W. J. Jellons, County Surveyor, in 1935. Claims to have set corner from remains of original hemlock and maple stumps (near by gone). It also checked with 4.00 chain call to swamp north of corner. Post sets in remains of old fence line. about 1/2 mile for 1576.

Description of corner evidence found:

Recovered 2" iron pipe with grass on stand 137-120-111, sec. 12, T. 7, R. 10, 13. No other evidence recovered.

Description of monument and accessories I established to perpetuate the original location of this corner.

As witness pipe was in perfect condition, it was left in place but painted blue. 1576 - red oak 7" x 30" x 60.5 links, maple 6" x 70" x 58.1 links, birch 6" x 120" x 73 links, birch 6" x 80" x 58.4 links, all serrated CP. Corner sets in SW corner of an old field. monument projects 24" above ground.

Dated at Mineralander, Wis., this 22nd day of September, 1976

Signature *Philip T. Hanson* Title registered land surveyor Registration No. 3498  
(County Surveyor, Registered Land Surveyor, or other duly authorized official)

Office of Register of Deeds, County of Oneida  
Instrument was filed in this office for record on the 15th day of September, 1976 at 10:30 o'clock A. M.

*Tomie L. Hanson*  
(Register of Deeds)

By \_\_\_\_\_ Deputy

3710120000