

CERTIFIED LAND CORNER RESTORATION

Index No. **G-1**

State of Wisconsin

County of Waushara } ss.



I Phillip T. Hansen, do hereby certify that on the 16th day of September, 1976, I found evidence of the quarter corner of section 7 & 12 Township 37, North, Range 10 & 11 east, Fourth Principal Meridian, as described hereon; and that from this evidence I established a new monument and accessories as described hereon to perpetuate the original location of this corner.

Resident witnesses:

Glen Barker

Jim Staflin

Herb Masoner

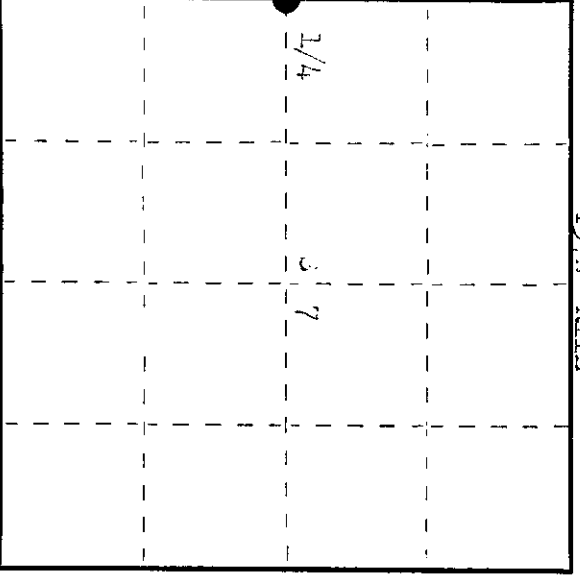 

○ = Corner monument restored.

History of original corner establishment:

Original corner established by Hiram J. Fellows, Deputy Surveyor, in 1859, Tamarack 3" bears S 15° W 17 links and Tamarack 9" bears S 80° W 25 links. Corner recovered by V...aine, County Surveyor, in 1935. Claims to have found a very old scribed post and stump of original tamarack S 80° W 25 links, also found part of another old stake deep down in moss. Set new scribed post and marked with spruce 5" N 32° W 25 links, spruce 4" N 35° W 6 1/2 links. Corner recovered by Blm. in 1959. Set iron pipe with brass cap.

Description of corner evidence found:

recovered. Blm.'s old 3" squared spruce post section 1/4 - 1/4. Also recovered Blm.'s 2" iron pipe with 3" brass cap projecting 9" above ground. recovered 5" N 32° W 25 links, now a decayed stump. spruce 4" N 35° W 6 1/2 links, now a decayed stump. spruce 5" N 30° W 10 links, scribed 1/4 - 1/4 Blm. now dead. spruce 4" N 10° W 25 1/4 links, scribed 1/4 - 1/4 Blm.

Description of monument and accessories I established to perpetuate the original location of this corner.

As the Blm. monument is in perfect condition, left in place, set an 8" picket with blue flagging next to it. This cap is scribed: U.S. District Survey 1/4 Blm. Black spruce 5" N 34° W 5 1/2 links, scribed 1/4 Blm. Black spruce 5" N 30° W 40 3/4 links, scribed 1/4 Blm. All was removed to Blm. monument.

400-4116
1959
Bureau of Land Management

Dated at Waushara, Wis., this 2nd day of September, 1976.

Signature Phillip T. Hansen Title Registered and Surveyor Registration No. 3-498
(County Surveyor, Registered Land Surveyor, or other duly authorized official)

Office of Register of Deeds, County of Waushara I hereby certify that the within instrument was filed in this office for record on the 14th day of December, 1976 at 10:30 o'clock A. M.

Erna George Keehn
(Register of Deeds)

By: _____ Deputy

3710122000