


CERTIFIED LAND CORNER RESTORATION


W 1 Index No. N-1

State of Wisconsin }
 County of Oneida } ss.

I Philip T. Hansen, do hereby certify that on the 16th day of May 19 75, I found evidence of the Section Corner corner of S13, S18, S19, and S24 Township 37N, North, Range 10 and 11 East, Fourth Principal Meridian, as described hereon; and that from this evidence I established a new monument and accessories as described hereon to perpetuate the original location of this corner.

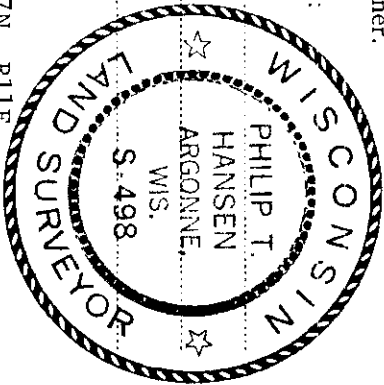

Resident witnesses:

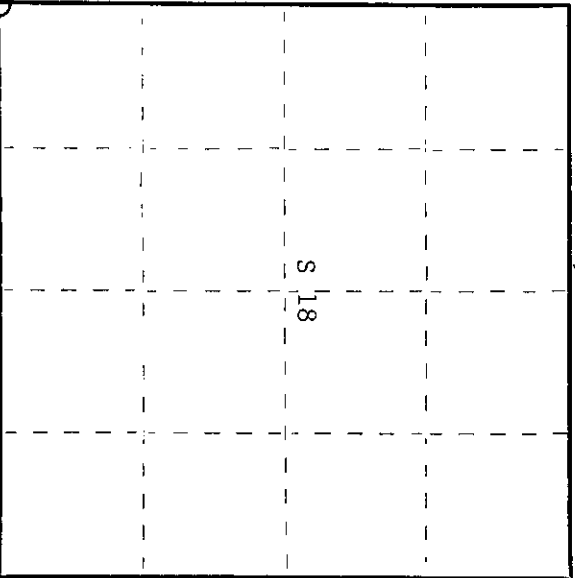

○ = Corner monument restored.

History of original corner establishment:
 Original corner established by Hiram C. Fellows, Government Deputy Surveyor, in 1859 from which tamarack 12" bears S58°W, 38 links; tamarack 9" bears N18°W, 8 links; tamarack 6" bears N57°E, 13 links; and tamarack 6" bears S35°E, 11 links. Set a 6" x 6" corner recovered and restored by Harry Hall, County Surveyor, in 1934. Set a 6" x 6" concrete monument with brass cap stamped, Official Survey Oneida County, original section corner S13, S18, S19, S24; T37N; R10 and R11E; Hall, 1934.
 Corner recovered by H.C. Lawrence, Registered Land Surveyor, in 1947. Set 4" cedar post, squared and scribed, beside the 6" x 6" concrete monument.

Description of corner evidence found:
 Recovered 6" x 6" concrete monument with brass cap, very good condition, stamped -
 Recovered 4" cedar post, squared and scribed S24, R10E; S19, R11E;
 S18, T37N; S13, T37N. Good condition.

Old BT's - tamarack 12" (stump) S58°W 88 links
 tamarack 6" (stump) S35°E 11 links

These are now decayed so bad they are only mounds.

Official Survey, Oneida County
 Original Section Corner
 S13 | S18
 S24 | S19
 T37N, R10 & 11E
 Hall, 1934

Description of monument and accessories I established to perpetuate the original location of this corner.
 Set support post beside concrete monument.

NBT's - Tamarack 5" N59°E 78.0 links scribed SC BT
 Tamarack 4" N58°W 95.8 links scribed SC BT

Dated at Rhineland, Wis., this 14th day of July, 1975.

Signature: *Philip T. Hansen* Title: Registered Land Surveyor Registration No. S-498
 (County Surveyor, Registered Land Surveyor, or other duly authorized official)

Office of Register of Deeds, County of Oneida
 Instrument was filed in this office for record on the 1st day of October, 1975 at 5:00 o'clock P.M.
Doris Terape Fuchsel (Register of Deeds)

By: _____ Deputy

3710130800