



CERTIFIED LAND CORNER RESTORATION

M I Index No. **M-1**

State of Wisconsin }  
County of Oneida } ss.

I Philip T. Hansen, do hereby certify that on the 19th day of June 1975, I found evidence of the S-1/16 corner of Sections 13 and 18 Township 37 North, Range 10 and 11 East, Fourth Principal Meridian, as described hereon; and that from this evidence I established a new monument and accessories as described hereon to perpetuate the original location of this corner.

Resident witnesses:

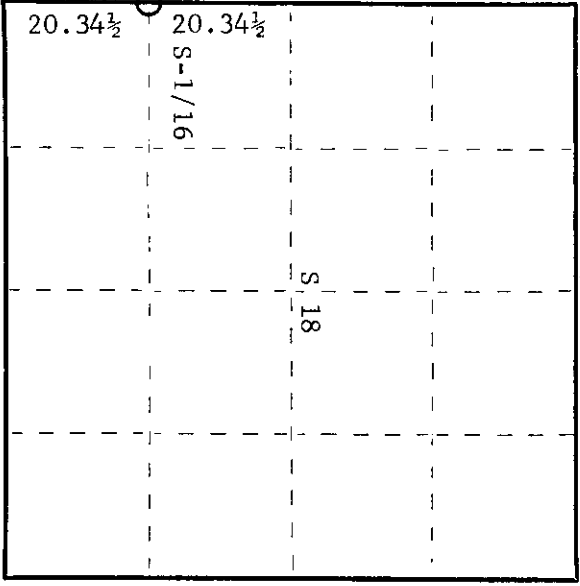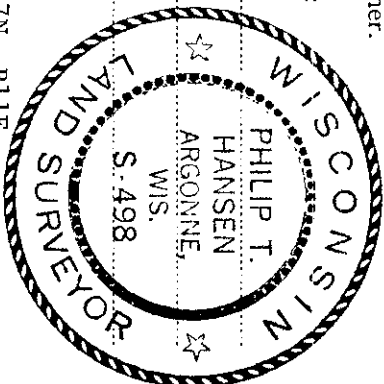

O = Corner monument restored.

History of original corner establishment:  
Original corner established by D.H. Vaughan, County Surveyor, in 1898. He set the corner from his re-established 1/4 corner and section corner, S18, S13, S24, and S19. Set white pine BT 18", N25°W, 35 1/2 links.

Corner set by V.M. Maine, County Surveyor, in 1936. Set BT white pine 18", S65°W, 30 links. Corner restored in 1959 by H.C. Lawrence, Registered Land Surveyor. He set a 6" post from Vaughan's BT which he recovered. Although burned, the scribe marks were unmistakably Vaughan's. Established NBT's aspen 9", N80°W, 17 links and aspen 10", N25°E, 37 links. Maine's S-1/16 post is 10 links North of a point 9 1/2 links East of Vaughan's.

Description of corner evidence found:  
Recovered H.C. Lawrence's cedar post, squared and scribed S13, R10E, S-1/16, T37N; S18, R11E, S-1/16; this was in good condition.

Recovered OBT - Aspen 15' stub N30°E 37.3 links

No evidence of white pine stump.

Description of monument and accessories I established to perpetuate the original location of this corner.  
Replaced wooden post with 1 1/2" OD iron pipe with 2" brass cap scribed -

NBT's - White birch 5" N22°E 21.5 links R S498  
Aspen 7" S25°E 57.2 links scribed 1/16 BT T37N  
R 10 S13 S18 11  
E S-1/16 E

CPT-1975

Dated at Rhineland, Wis., this 15th day of July, 1975.

Signature *Philip T. Hansen* Title Registered Land Surveyor Registration No. S-498  
County Surveyor, Registered Land Surveyor, or other duly authorized official.

Office of Register of Deeds, County of Oneida  
Instrument was filed in this office for record on the 1st day of October 1975 at 3:00 o'clock P.M.  
I hereby certify that the within

*Doris Savage Tucker*  
(Register of Deeds)

By: Deputy