



CERTIFIED LAND CORNER RESTORATION

Index No. L-1

State of Wisconsin }
County of Oneida } ss.

I, Philip T. Hansen, do hereby certify that on the 19th day of June, 1975, I found evidence of the Quarter corner of Sections 13 and 18 Township 37 North, Range 10 & 11 East, Fourth Principal Meridian, as described hereon; and that from this evidence I established a new monument and accessories as described hereon to perpetuate the original location of this corner.

Resident witnesses:

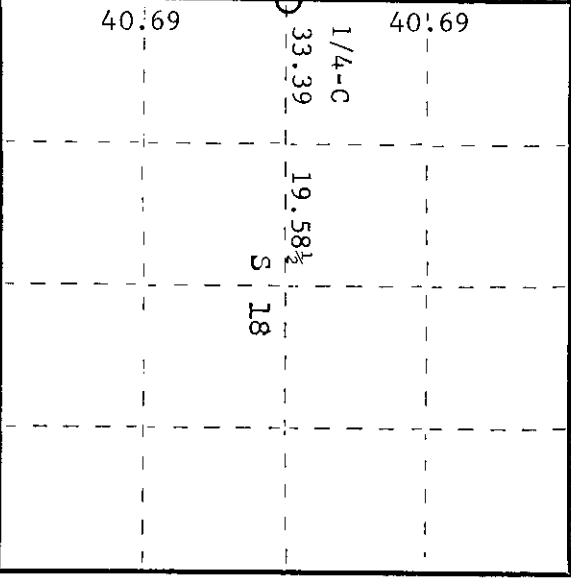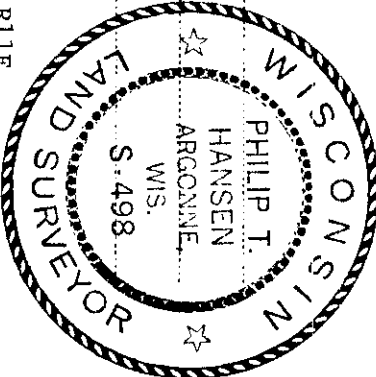

O = Corner monument restored.

History of original corner establishment: Original corner established by Hiram C. Fellows, Government Deputy Surveyor, in 1859 from which white birch 7" bears N67°E, 21 links and white birch 7" bears N74°W, 12 links. Corner recovered by D.H. Vaughan in 1898. No new corner or new BT's were noted as having been set.
Corner set by V.M. Maine, County Surveyor, but he set his post equidistant between Section 13 and Section 18 at 40.69 chains. He did not recover Vaughan's corner.
Corner recovered by H.C. Lawrence in 1960. Found both Vaughan's and Maine's 1/4 corner. Maine's is 59 links East of Vaughan's. As Vaughan had recovered the original corner, this was accepted. Set new post from which aspen 9" bears S12°W, 24 1/2 links and aspen 9" bears N63°W, 26 links.
Description of former evidence found:
Recovered H.C. Lawrence's 4" cedar post, squared and scribed 1/4S S18, 1/4S S13, in good condition which he had set at D.H. Vaughan's corner. This post in good condition.
Recovered boulder 14 x 26", S27°E, 42 links.

Description of monument and accessories I established to perpetuate the original location of this corner. Replaced Lawrence's 4" cedar post with 2 1/2" iron pipe with brass cap stamped -

NBT's - White birch 8"	N66°E	19.0 links	scribed 1/4 BT	R	S498
B. spruce 5"	S83°W	31.1 links	scribed 1/4 BT	R	T37N
				R	S13/S18
				E	11
				E	CPI-1975

Dated at Rhinelander, Wis., this 19th day of June, 1975.

Signature: *Philip T. Hansen* Title: Registered Land Surveyor Registration No. S-498
County Surveyor, Registered Land Surveyor, or other duly authorized official

Office of Register of Deeds, County of Oneida, at 10:00 o'clock P.M. that the within instrument was filed in this office for record on the 19th day of June, 1975.

Doris Savage Tucker
(Register of Deeds)

By: Deputy

8710132000