CERTIFIED LAND CORNER RESTORATION

Index No. K-1

State of Wisconsin
County of Oneida } ss.

I Philip T. Hansen, do hereby certify that on the 16th day of September, 19 76, I found evidence of the N 1/16 corner of Section 13 and 18 Township 37, North, Range 10 & 11 East, Fourth Principal Meridian, as described hereon; and that from this evidence I established a new monument and accessories as described hereon to perpetuate the original location of this corner.

Resident witnesses:

Glen Parker

Jim Claflin

Herb Wagoner

WISCONSIN S-498 LAND SURVEYOR

T37N R11E

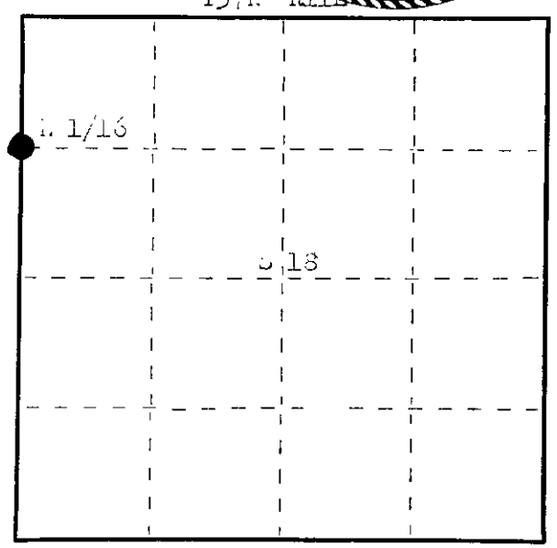

O = Corner monument restored.

History of original corner establishment:

Corner established by W. Lance, County Surveyor.
Set N 1/16 at 21.03 chains north of the corner. Set 5" post and marked
BTs - Tamarack stump 5" S 40° E 70 links, Spruce 3" S 65° W 11 links
and Spruce 4" S 4° E 31 links.

Description of corner evidence found:

Recovered 5" squared and scribed 1/8S - 1/8S in very poor condition.
Recovered Tamarack stump - 5" S 40° E 70 links (17 links), scribed BT.
Black Spruce 3" S 65° W 11 links, now an 18" stub, scribed BT.
Black Spruce 4" S 4° E 31 links, now dead, scribed BT.

Description of monument and accessories I established to perpetuate the original location of this corner.
Replaced with 1½" OD iron pipe with brass cap stamped.
Monument projects 4" above ground.
BT - Tamarack 4" N 11° W 10 links.
Black Spruce 5" N 44° E 13.5 links, scribed 1/16 BT.
Monument and BTs painted blue.

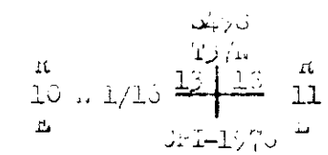

Dated at Rhinelander, Wis., this 2nd day of September, 19 76

Signature Philip T. Hansen Title Registered Land Surveyor Registration No. S-498
(County Surveyor, Registered Land Surveyor, or other duly authorized official)

Office of Register of Deeds, County of Oneida I hereby certify that the within instrument was filed in this office for record on the 9th day of November, 19 76 at 1:30 o'clock P M.

Doris Verage Kuehn
(Register of Deeds)

By ..... Deputy

FORM 985 R. C. MILLER CO., MILWAUKEE

37101330000