

CERTIFIED LAND CORNER RESTORATION

State of Wisconsin }
County of Oneida } ss.

I Norman Loftus, do hereby certify that on the 30 day of August, 1984, I found evidence of the Northeast corner of Section 22 Township 37 North, Range 10 West, Fourth Principal Meridian, as described hereon; and that from this evidence I established a new monument and accessories as described hereon to perpetuate the original location of this corner:

Description of original monument and accessories and subsequent restorations:


Original corner set by Wm. Daugherty 1843. Hall could not find corner in 1920 whereby he double proportioned the corner location and set an iron pipe 2.54 chains West of North-South Road.

Description of corner evidence found:

11" OD iron pine flush to blacktop. Hall's Southwest White Pine stump 11" is badly rotted. Someone has driven a 2" iron shaft at or near the face. Two BT's origin Unknown marked Approx. 10 years ago (Jack Pine 14", S 30° W 43.83') (Jack Pine 8", S 36° E, 62.81'). There is another Iron pipe badly bent to the East in the surface of the blacktop 3.1' to the top as now located.

Description of monument and accessories I established to perpetuate the location of this corner:

As most of the evidence coincides quite well with Hall's location I made no additional mounumentation.

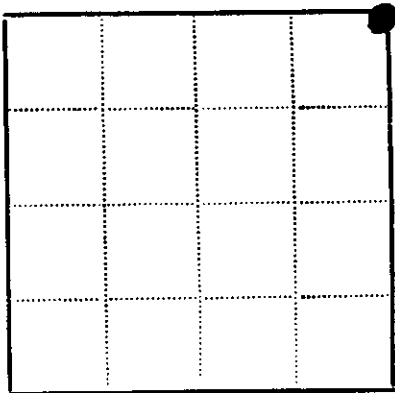

Legend: Circle - Corner monument restored; Square -

Resident witnesses Todd Loftus

Dated at Rhinelanders Wisconsin, this 15 day of October 1984.

Signature Norman Loftus Title Registered Land Surveyor (County Surveyor, Registered Land Surveyor, or other duly authorized official)

Surveyors Registration No. 257

Office of REGISTER OF DEEDS County of Oneida

I hereby certify that the within instrument was filed in this office for record on the 3rd day of December 1984, and was filed in Book No. Page No. of County Records.

Signature Lois Verage Kuehn Title REGISTER OF DEEDS

Township, Range, Section, Index No., Page No.

