

CERTIFIED LAND CORNER RESTORATION

Index No. L-7


State of Wisconsin

County of Oneida } ss.


I, Phillip T. Hansen, do hereby certify that on the 14th day of May, 1980, I found evidence of the C. 1/4 corner of Section 17

Township 37, North, Range 10 East, Fourth Principal Meridian, as described hereon; and that from this evidence I established a new monument and accessories as described hereon to perpetuate the original location of this corner.

Resident witnesses:
Jim Clafflin
Herb Wagoner

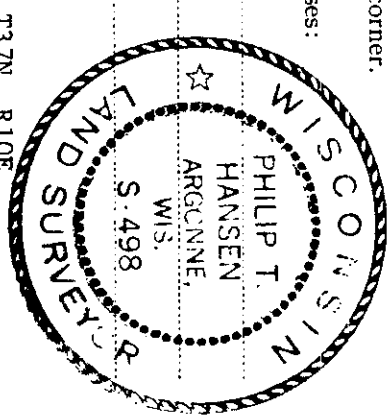

T37N R10E

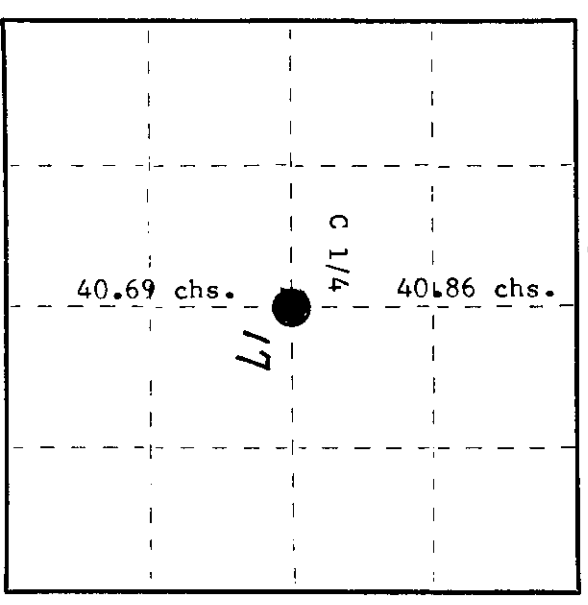

O = Corner monument restored.

History of original corner establishment:

Corner established by N. Loftus, Ripco surveyor, in 1958.
Corner established by running N-S and E-W 1/4 lines from previously established 1/4 corners.
Set iron pipe with brass cap and marked NBT's -
Tamarack 5" N29°W 23.5 links
B1. Spruce 3" S75°W 8-1/4 links

Description of corner evidence found:

Recovered 2" iron pipe with 3" brass cap, stamped:
Recovered OBT's -
B1. Spruce 3" (4") S75°W 8.25 links (9.00 Links) T37N R10E
scribing grown over. C-1/4 S17
Tamarack 5" (6") N29°W 23.5 links RIPCO
scribing partially legible.

Description of monument and accessories I established to perpetuate the original location of this corner.
Monument left as recovered.

Marked NBT -
B1. Spruce 4" S23°E 4.5 links, scribed 1/16 BT.

Dated at Rhineland, Wis. this 21st day of July, 1980

Signature: Phillip T. Hansen Title: Registered Land Surveyor Registration No. S-498
(County Surveyor, Registered Land Surveyor, or other duly authorized official)

Office of Register of Deeds, County of Oneida
Instrument was filed in this office for record on the 21st day of July, 1980
at 3:35 o'clock P. M. I hereby certify that the within

By: Doris George Fuchs Deputy
(Register of Deeds)