

CERTIFIED LAND CORNER RESTORATION

Index No. K-9



State of Wisconsin

County of Oneida } ss.

I Philip T. Hansen, do hereby certify that on the 2nd day of October, 1979, I found evidence of the N 1/16 corner of Sections 16 and 17

Township 37, North, Range 10 East, Fourth Principal Meridian, as described hereon; and that from this evidence I established a new monument and accessories as described hereon to perpetuate the original location of this corner

Resident witnesses
Jim Claflin
Herb Wagoner

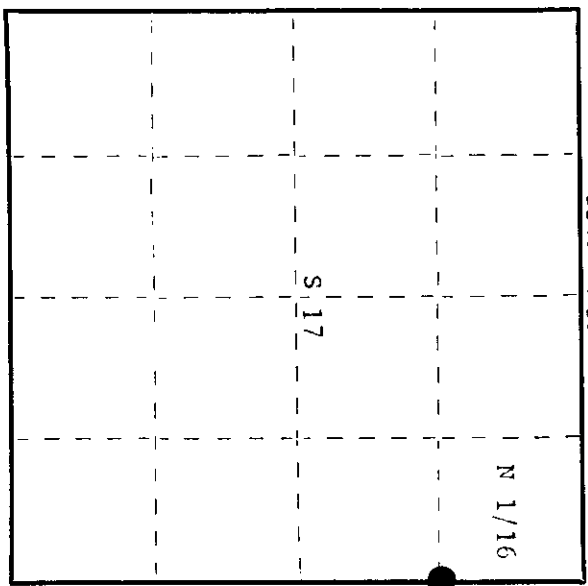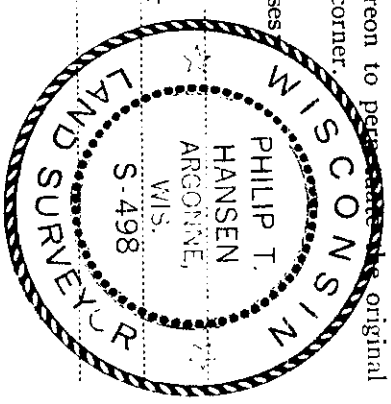

○ = Corner monument restored.

History of original corner establishment:

Corner established by Abernathy. No records of BT's established.

Description of corner evidence found:

Recovered 1/2" lead pipe, flush with the ground on the east shoulder of Snafford Road. The top part was bent, but the bottom half was still in vertical position.

Recovered CBT's -
White Pine 10" N65°E 14.4 links
Red Pine 10" S47°E 49.7 links
scribing partially visible on both BT's.

Description of monument and accessories I established to perpetuate the original location of this corner.
Removed lead pipe from ground, straightened it and replaced it in same hole, 6" below the surface.
Set an iron pipe with brass cap for witness corner 30 links east, cap stamped:
Monument projects 18".

T37N RICE
N 1/16 17+16 W.C.
W - 30 lks

Dated at Rhineland, Wis., this 9th day of October, 1979.

Signature Philip T. Hansen Title Registered Land Surveyor Registration No. S-498
(County Surveyor, Registered Land Surveyor, or other duly authorized official)

Office of Register of Deeds, County of Oneida hereby certify that the within instrument was filed in this office for record on the 3rd day of December, 1979 at 1:15 o'clock P. M.

Doris Leverage Kuehn
(Register of Deeds)

By: _____ Deputy