

CERTIFIED LAND CORNER RESTORATION

Index No. K-6



State of Wisconsin

County of Oneida } ss.

I Phillip T. Hansen, do hereby certify that on the 31st day of May, 1978, I found evidence of the NW 1/16 corner of the Section 17 Township 37, North, Range 10 East, Fourth Principal Meridian, as described hereon; and that from this evidence I established a new monument and accessories as described hereon to perpetuate the original location of this corner.

Resident witnesses:

Jim Clafin
Herb Wagoner
J. Masbaum

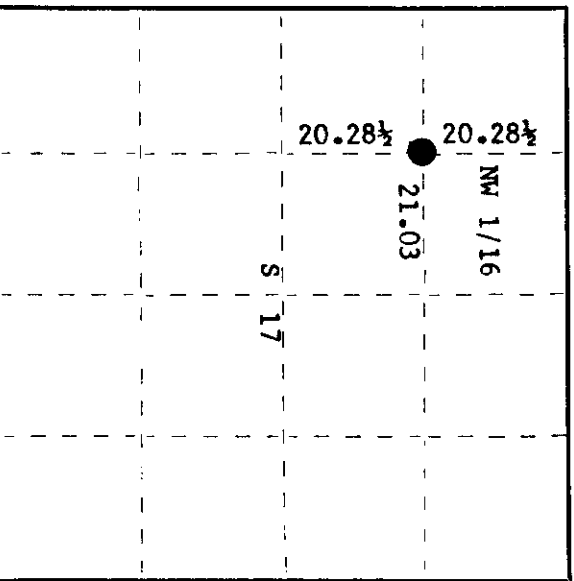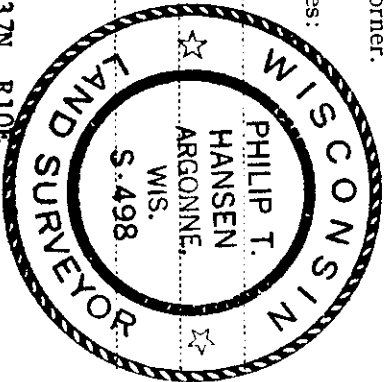

○ = Corner monument restored.

History of original corner establishment:

Corner established by N. Loftus, Ripco surveyor. Ran random line south, bearing $186^{\circ} 45'$ from W 1/16, north line, previously established 40.56 1/2 chains to close out 3 links east of WC 1/16 corner.
Set NW 1/16 at 20.28 1/2 chains intermediate.
Marked NBT's - Maple 3" $N36^{\circ}E$, 13 1/2 links
Maple 4" $S88^{\circ}E$, 24 1/2 links

Description of corner evidence found:

Recovered 3/4" iron pipe with 2" square brass cap in very poor condition. Monument had been run over with skidder from recent logging operations. Recovered OBT's - Maple 3" (5") $N36^{\circ}E$, 13.5 links, scribing grown over. Maple 4" $S88^{\circ}E$, 24.5 links, now a cut off stump.

Description of monument and accessories I established to perpetuate the original location of this corner.

Replaced monument with 1" iron pipe with 2" brass cap, stamped:
Monument projects 24" above ground.
Marked NBT - Maple 5" $S83^{\circ}E$, 97.3 links, scribed 1/16 BT.

S498
T37N R10E
NW 1/16 S 17
CPI-1978

Dated at Rhinelander, Wis., this 5th day of June, 1978

Signature Phillip T. Hansen Title Registered Land Surveyor Registration No. S-498
(County Surveyor, Registered Land Surveyor, or other duly authorized official)

Office of Register of Deeds, County of Oneida
at 11:35 o'clock A M. 26th day of June, 1978
I hereby certify that the within instrument was filed in this office for record on the 26th day of June, 1978

Doris Urzaga Kuehn
(Register Deeds)

By: _____ Deputy