

CERTIFIED LAND CORNER RESTORATION

Index No. L-5

State of Wisconsin

County of Oneida } ss.



I Phillip T. Hansen, do hereby certify that on the 31st day of May, 1978, I found evidence of the Quarter corner of Section 17 & 18 Township 37, North, Range 10 East, Fourth Principal Meridian, as described hereon; and that from this evidence I established a new monument and accessories as described hereon to perpetuate the original location of this corner.

Resident witnesses:

Jim Claffin

Herb Wagoner

J. Masbaum

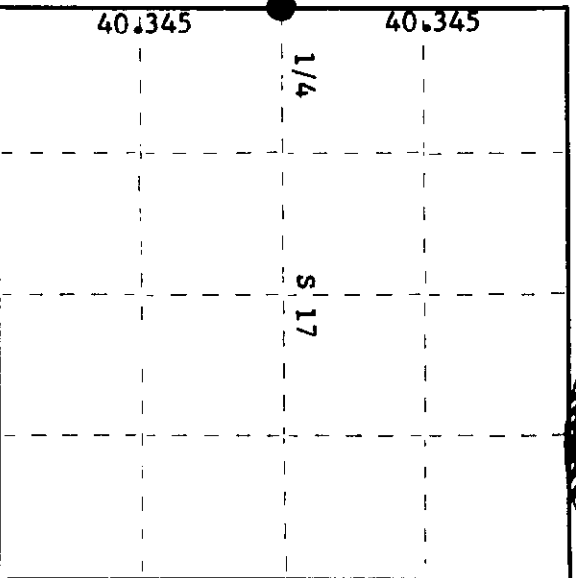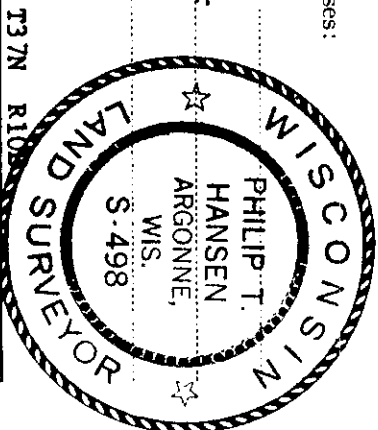

○ = Corner monument restored.

History of original corner establishment:

Corner established by proportion by Goddard and crew, Ripco surveyors. Ran random line N 7° E from section corner 17, 18, 19 & 20 80.39½ chains to close out 82 links east of recovered Section Corner 7, 8, 17, 18. Set west 1/4 corner at 40.345 chains 41.1 links west.

Marked NBT's - Birch 7" S34°W, 35½ links  
Birch 5" N25°W, 49½ links

Description of corner evidence found:

Recovered Ripco's 2" iron pipe with 3" square brass cap in good condition. Cap stamped:

Recovered OBT's -

White Birch 7" (9") S34°W (S38°W) 35.5 links,

scribed 1/4 S18 BT.

White Birch 5" (8") N25°W (N29°W) 49.5 links,

scribed 1/4 S18 BT.

1/4  
S18 S17  
T37N R10E

Description of monument and accessories I established to perpetuate the original location of this corner.

Monument left in place as recovered.

Monument projects 15" above ground.

NBT's -

Red Pine 6" N45°W, 3.9 links

Red Pine 6" N14°E, 6.5 links

Red Pine 4" Due east, 6.0 links

Red Pine 4" S2°E, 19.8 links

all scribed 1/4 BT.

Dated at Rhineland, Wis., this 5th day of June, 1978

Signature Phillip T. Hansen Title Registered Land Surveyor Registration No. S-498  
(County Surveyor, Registered Land Surveyor, or other duly authorized official)

Office of Register of Deeds, County of Oneida  
Instrument was filed in this office for record on the 26th day of June, 1978  
at 1:35 o'clock P.M. I hereby certify that the within

Doris Venage Fuchs  
(Register of Deeds)

By..... Deputy