

CERTIFIED LAND CORNER RESTORATION

Index No. K-5

State of Wisconsin

County of Oneida } ss.

I, Phillip T. Hansen, do hereby

certify that on the 15th day

of June, 1979, I found

evidence of the N 1/16

corner of Sections 17 and 18

Township 37, North, Range

10, East, Fourth Principal Meridian,


as described hereon; and that from this evidence

I established a new monument and accessories

as described hereon to perpetuate the original

location of this corner.


T37N R10E

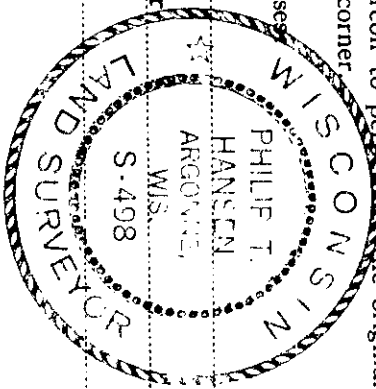

Resident witnesses

Jim Claflin

Herb Wagoner

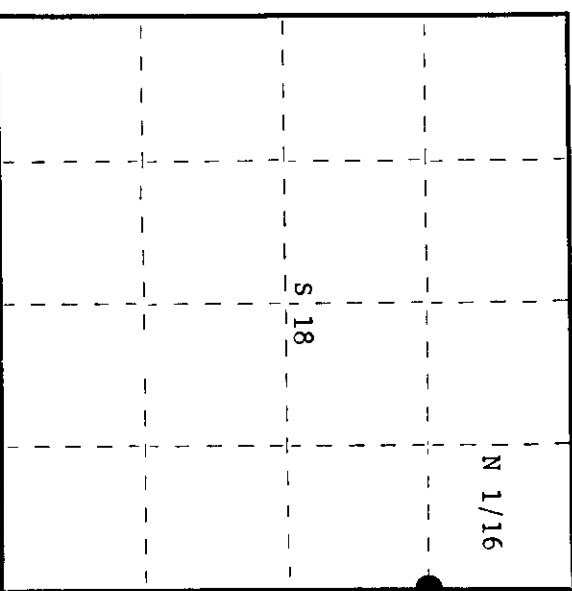

○ = Corner monument restored.

History of original corner establishment:

Corner established by N. Loftus, Ripco surveyor. Ran random line N 7° E from section corner 17, 18, 19 and 20, 80.39-1/2 chains to close out 82 links east of section corner. Established N 1/16 corner at 60.37 chains - and 61.57 links west.

Marked NBT's -

Maple 5' S85°E 32-1/2 links

Birch 4' N14°W 78 links

Description of corner evidence found:

Recovered both of Ripco's OBT's - only stumps remain but scribing visible. No trace of old monument recovered, believed destroyed by cutting operation or planting operations. Re-established old position from ties to recovered BT's.

Description of monument and accessories I established to perpetuate the original location of this corner.

Set a new 1-1/2" iron pipe with 2" brass cap projecting 24" above ground. Cap stamped:

Marked NBT's -

R.Pine 5" S8°W 14.6 links

R.Pine 5" N32°W 10.2 links

both scribed 1/16 BT.

T37N R10E

18 17

N 1/16

CPT-1979

Dated at Rhineland, Wis., this 18th day of June, 1979

Signature Phillip T. Hansen Title Registered Land Surveyor Registration No. S-498

County Surveyor, Registered Land Surveyor, or other duly authorized official

Office of Register of Deeds, County of Oneida, 7th day of August, 1979

at 100 o'clock M.

Doris Margaret Truckner
(Register of Deeds)

By Doris Margaret Truckner Deputy

2710183000