

CERTIFIED LAND CORNER RESTORATION

Index No. 0-3

State of Wisconsin



County of Oneida } ss.

I, Phillip T. Hansen, do hereby certify that on the 11th day of June, 1979, I found evidence of the NC 1/16 corner of Section 19 Township 37, North, Range 10 East, Fourth Principal Meridian, as described hereon; and that from this evidence I established a new monument and accessories as described hereon to perpetuate the original location of this corner.

Resident witnesses:

Jim Claflin

Herb Wagoner

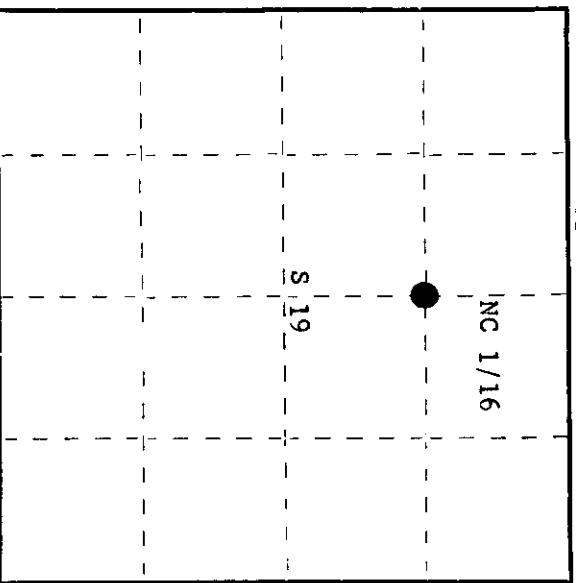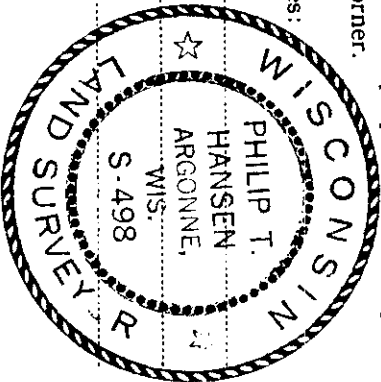

○ = Corner monument restored.

History of original corner establishment:

Corner established by N. Loftus, Ripco Surveyor. Ran random line north from S 1/4 section 19, 82.44 chains to close out 1.19 chains west of N 1/4 corner. Corrected bearing N 2° 10' W. Set NC 1/16 at 61.95-1/2 chains, .894 chains east. Marked NBT's -
W.Pine 9" S1°W 24 links
R.Pine 7" N4°E 10 links

Description of corner evidence found:

Recovered Ripco's OBT's - W.Pine 9" (16") S1°W (S4°W) 24 links, scribing grown over. Recovered OBT - Red Pine 7" (9") N4°E (N8°E) 10.0 links, scribing partially legible. Recovered an old rotted stake from ties to old BT's.

Description of monument and accessories I established to perpetuate the original location of this corner.
Replaced old rotted stake with 1-1/2" iron pipe with 2" brass cap projecting 18" above ground. - cap stamped:
Monument on edge of red pine plantation.

S498
T37N R10E
NC 1/16 S19
CPI-1979

Dated at Rhineland, Wis., this 18th day of June, 1979

Signature: Phillip T. Hansen Title: Registered Land Surveyor Registration No. S-498
(County Surveyor, Registered Land Surveyor, or other duly authorized official)

Office of Register of Deeds, County of Oneida I hereby certify that the within instrument was filed in this office for record on the 17th day of August, 1979 at 10:00 o'clock P. M.

Doris M. Keck
(Register of Deeds)

By: _____ Deputy

3710193020