


U.S. PUBLIC LAND SURVEY MONUMENT RECORD

Note: This form is intended and designed to fulfill all requirements of Wisconsin Administrative Code, Chapter A-E 7.08 U.S. Public Land Survey Monument Record (3) (a) (b) (c) (d) (e) (f) (g) (h) (i). An additional sheet may be added if necessary to conform with said requirements.

(a) Corner location: Township 37 North
 Range 10 East/West

Town/City/Village Stella

County Oneida

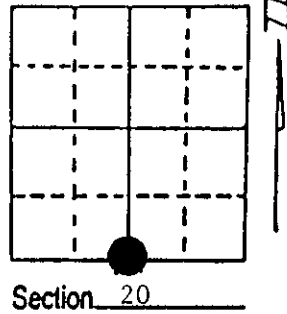

(b) (f) (g) (h) Description of monument found at this corner and if it was accepted, state all evidence (material, testimonial, occupational, plats, records, other monuments) used as a basis for accepting. If not accepted or if nothing was found, state evidence used as basis for establishing location. If re-established through lost corner proportionate methods, indicate all monuments, distances and directions used to establish. Indicate type of monument found or set and sign post.

1863 - Wm. Daugherty established corner and set wood post and two BTs:
 12" R. Pine, S67°E, 19 links 12" R. Pine, N76°W, 34 links

9/1899 - B. F. Dorr could find no evidence of original corner and restored it.
 Set two new BTs:
 6" J. Oak, N74½°W, 15 3/4 links 20" Norway Stump, S73½°W, 44 links


1953 - B.L.M. restored corner by proportionate measure at 41.72 chains West of the Section Corner to Sections 20, 21, 28 and 29. They placed a 2 1/2" x 30" iron post with brass cap and two BTs:
 9" J. Pine, N2°E, 35 links (23.1') 6" J. Pine, S87°W, 29 1/2 links (19.47')

3/21/1989 - Milo E. Stefan found brass cap monument as set by B.L.M. in 1953 with 12" Jack Pine, S87°W, 19.62'. We made four new BTs and set plastic sign post.

(c) (d) (e) Plan view of corner with ties to at least 4 witness monuments. If in disagreement with previously established corner, show the distances between the two corners and also indicate the ties to the disputed corner.

1. B.L.M. brass cap monument
2. 8" Red Pine, N9°E, 48.66'
3. 10" Red Pine, East, 85.48'
4. 6" Red Maple, S21°E, 54.48'
5. 10" Jack Pine, S53°W, 2.95'
6. 12" Jack Pine, S87°W, 19.62'
7. Plastic sign post

Distance to nail in side of BTs.
 Stump blaze in each BT scribed "BT"

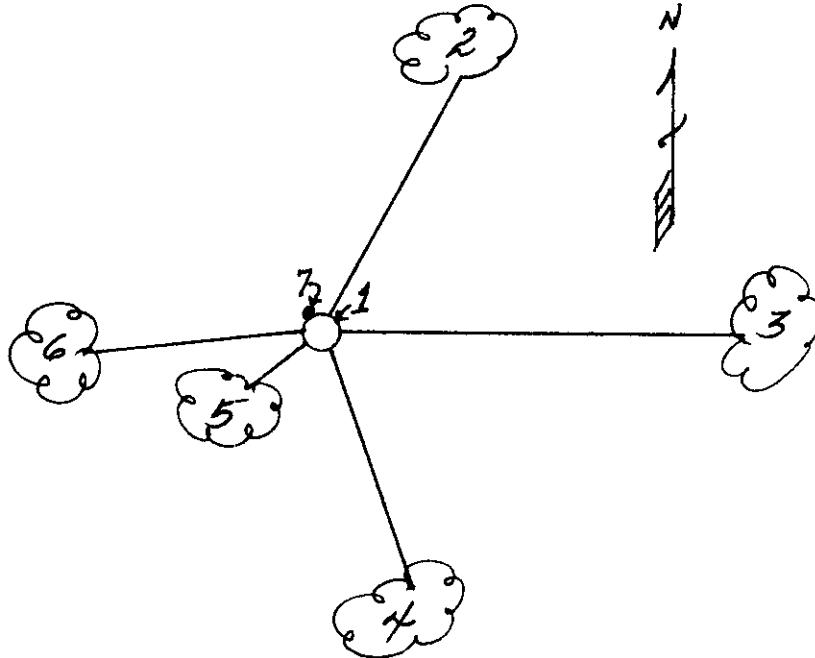

(i) I, Milo E. Stefan
 (type or print name) certify that the corner location on this record was determined by me or under my direction and control and that this U.S. Public Land Survey Monument Record is correct and complete to the best of my knowledge and belief.

Milo E. Stefan
 Signature

March 28, 1989
 Date



Index No. R-7