U.S. PUBLIC LAND SURVEY MONUMENT RECORD

Note: This form is intended and designed to fulfill all requirements of Wisconsin Administrative Code, Chapter A-E 7.08 U.S. Public Land Survey Monument Record (3) (a) (b) (c) (d) (e) (f) (g) (h) (i). An additional sheet may be added if necessary to conform with said requirements.

(a) Corner location: Township 37 North

Range 10 East/West

Town/~~City/Village~~ Stella

County Oneida

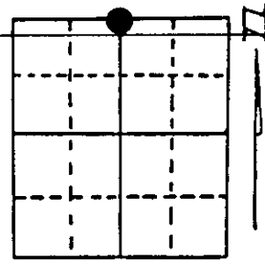

Section 25

(b) (f) (g) (h) Description of monument found at this corner and if it was accepted, state all evidence (material, testimonial, occupational, plats, records, other monuments) used as a basis for accepting. If not accepted or if nothing was found, state evidence used as basis for establishing location. If reestablished through lost corner proportionate methods, indicate all monuments, distances and directions used to establish. Indicate type of monument found or set and sign post.

1863 - William E. Daugherty established this corner.

12/11/1907 - D. H. Vaughan (county surveyor) restored corner by proportional measure from Section Corner - West and restored Meander Corner - East. (From Vaughan's and Dorr's notes, page 331 in county surveyor's office). Vaughan set a post and two new BTs:
17" W. Pine, N25°E, 37 Links (24.42')
13" W. Pine, S61 3/4°E, 22 Links (14.52')

7/23/1929 - H. C. Hall (county surveyor) found Vaughan's corner. Hall used corner to restore Section Corner one-half mile West at this time. Note on Page 23 of Hall's notes that he did not agree with Vaughan's restoration methods.

9/16/1991 - Milo E. Stefan found Vaughan's corner. A clear post hole and stumps in place for both White Pine BTs. From occupation that we find in Section 25, it is likely that Section 24 and 25 have been subdivided by using this Vaughan Quarter Corner. As it has been in place since 1907, and to restore it by other means would only cause many problems, I choose to accept the Vaughan position.

(c) (d) (e) Plan view of corner with ties to at least 4 witness monuments. If in disagreement with previously established corner, show the distances between the two corners and also indicate the ties to the disputed corner.

1) 2" x 30" aluminum monument in mound of stone.
2) Red Maple, 6", N5°W, 3.92 feet
3) Red Maple, 5", S39°E, 29.21 feet
4) Red Maple, 6", S1°W, 24.17 feet
5) Red Maple, 8", S61°W, 20.64 feet
6) White Pine Stump, N25°E, 24.42 feet
7) White Pine Stump, S62°E, 14.52 feet
8) Plastic sign post,

Distances to nail in side of tree.
BTs blazed and scribed "BT".

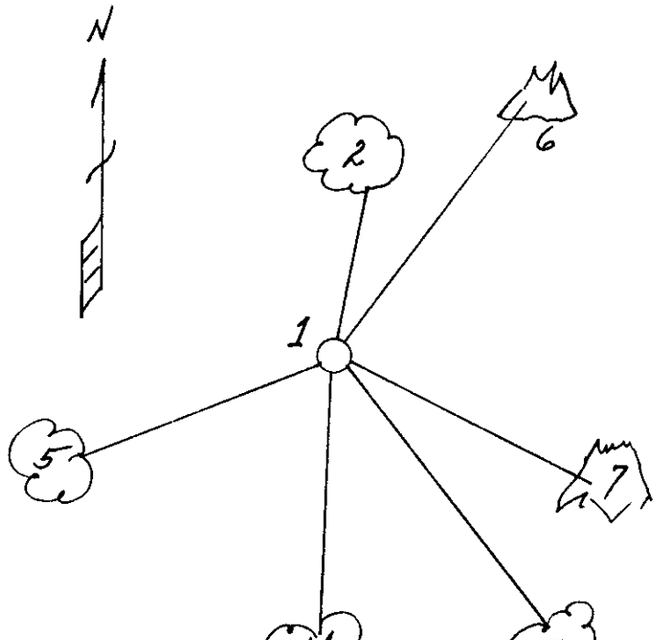

(i) I, Milo E. Stefan (type or print name) certify that the corner location on this record was determined by me or under my direction and control and that this U.S. Public Land Survey Monument Record is correct and complete to the best of my knowledge and belief.

Milo E. Stefan
Signature

9/24/91
Date

Stamp

Index No. R-23

3710240020