



CERTIFIED LAND CORNER RESTORATION

Index No. P-1

State of Wisconsin }  
County of Oneida } ss.

I Phillip T. Hansen, do hereby certify that on the 27th day of April, 1978, I found evidence of the Quarter corner of Section 24 & 19 Township 37, North, Range 10 & 11 East, Fourth Principal Meridian, as described hereon; and that from this evidence I established a new monument and accessories as described hereon to perpetuate the original location of this corner.

Resident witnesses:  
Jim Claflin  
Herb Wagoner  
J. Masbaum

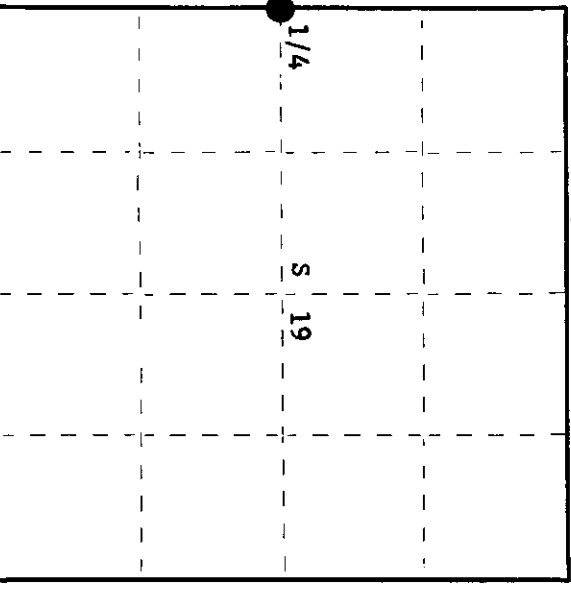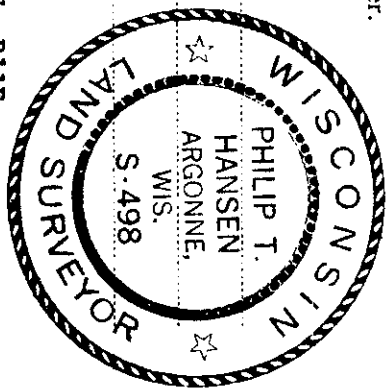

○ = Corner monument restored.

History of original corner establishment: Original corner established by Wm. E. Dougherty, Deputy Surveyor, in 1859 from which birch 10" bears S47°W, 23 links and aspen 12" bears N62°E 30 links.  
D.H. Vaughan, County surveyor; recovered original aspen BT in 1898. White Birch was gone. Marked NBT's - Maple 12" N44°E, 35 links; Maple 12" S22°W, 23 links.  
Corner recovered by H.C. Lawrence, Registered Land Surveyor. Marked NBT's - Oak 5" N75°W, 12 links and aspen 10" N65°E, 50 links.  
Also recovered Maine's 2 1/2" iron pipe with brass cap. No record on this monument. Notes call for new pitch pine post, scribed to replace Vaughan's old stake.

Description of corner evidence found:  
Recovered H.C. Lawrence's oak and cedar posts alongside Maine's iron pipe. Post scribed 1/4S S24, 1/4S S19.  
Recovered OBT's - Oak 5" (10") N75°W, 12.0 links, scribbling grown over.  
N65°E, 500 links.  
Maine's 2 1/2" iron pipe with brass cap stamped:  
Monument projects 28" above ground.

R10 R11  
S24 1-4 S19  
T37 M T37

Description of monument and accessories I established to perpetuate the original location of this corner.  
Recovered H.C. Lawrence's wood post and replaced it with Maine's 2 1/2" iron pipe.  
Monument projects 28" above ground.  
Marked NBT's - Oak 5" N61°E, 31.9 links  
Oak 10" S47°E, 36.6 links  
Maple 6" S45°W, 19.4 links  
all scribed 1/4 BT

Dated at Rhineland, Wis., this 15th day of May, 1978

Signature Phillip T. Hansen Title Registered Land Surveyor Registration No. S-498  
(County Surveyor, Registered Land Surveyor, or other duly authorized official)

Office of Register of Deeds, County of Oneida  
Instrument was filed in this office for record on the 28th day of May, 1978  
at 1:05 o'clock P. M.

Doris Verage Kuehn  
(Register of Deeds)

By Doris Verage Kuehn Deputy

000047012